

WATER SERVICE RECORD

Name George Mandigo

Service No. #42

Address 31 Roosevelt Road

H 2165

Location

Repair—Renewal—New Service WO #7214

Comm 6-25-62


Date	Material	Amount	Total	Date	Amount
5-11-62	Labor	2.31		5-11-62	50.00
	10% O.H.	.23	2.54	5-11-62	21.55
47'	3/4" Copper tubing @.42		19.74		28.45
1	3/4" C x 1/2 I.W.H. Stop & Waste		6.17		
			28.45		
					Non-charge
				21'	3/4" Copper tubing @.42 8.82
				1	3/4" C Curb Cock 6.28
				1	3/4" C Corp Cock 4.91
				1	Box & Rod 4.90
				1	1/2 Straight Tailpiece .50
				1	1/2 Offset Tailpiece .50
				5-11-62	Labor 1.93
					27.84

DATE _____

TOWN OF LEXINGTON — BOARD OF PUBLIC WORKS

WATER DIVISION

Sketch of Service Here

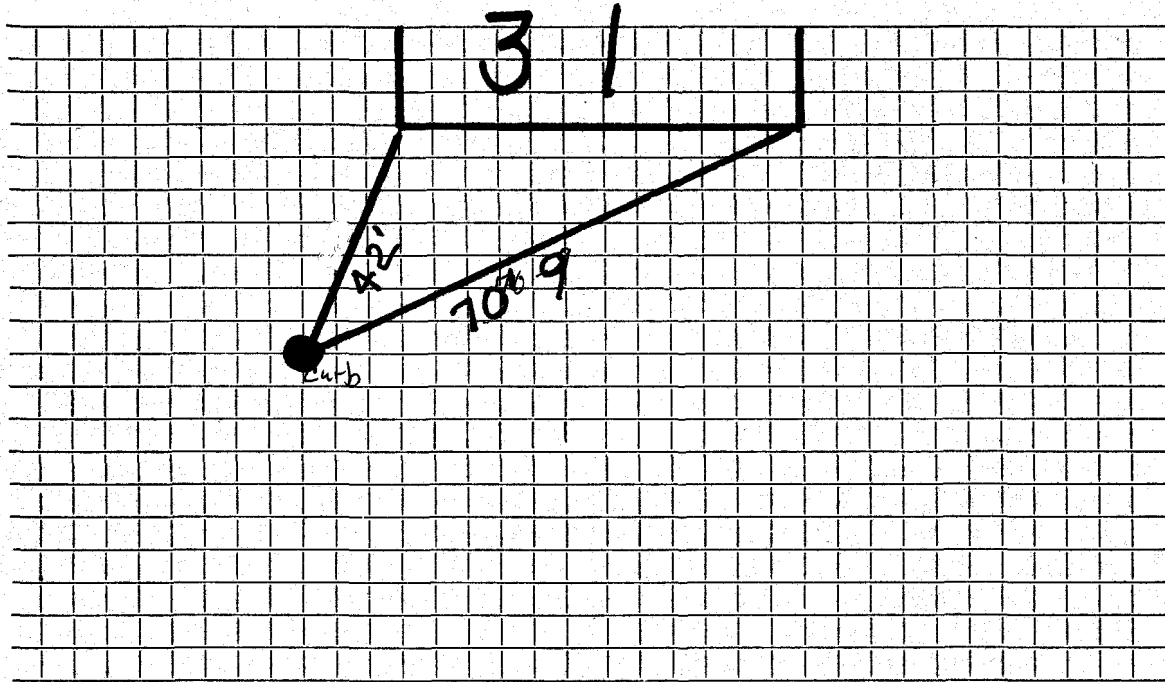

Connection made in Street. Work completed

Remarks:

.....

.....