

WATER SERVICE RECORD

Name George Mandigo

Service No. #43

Address 32 Roosevelt Road

Location

Repair—Renewal—New Service WO #7215

Comm 6-25-62


Date	Material	Amount	Total	Date	Amount	
5-14-62	Labor	2.31		5-7-62	Deposit	50.00
	10% O.H.	.23	2.54	6-25-62	Returned	16.09
60'	3/4" Copper tubing @42		25.20			33.91
1	3/4" Cx 1/2 I/W.H. Stop & Waste		6.17			
			33.91		Non Charge	
				5-14-62	Labor	1.93
				86'	3/4" Copper tubing @42	36.12
				1	3/4" Corp Cock	4.91
				1	3/4" Curb Cock	6.28
				1	Box & Rod	4.90
				1	1/2 Straight Tailpiece	.50
				1	1/2 Offset Tailpiece	.50
						55.14

DATE _____

TOWN OF LEXINGTON — BOARD OF PUBLIC WORKS

WATER DIVISION

Sketch of Service Here

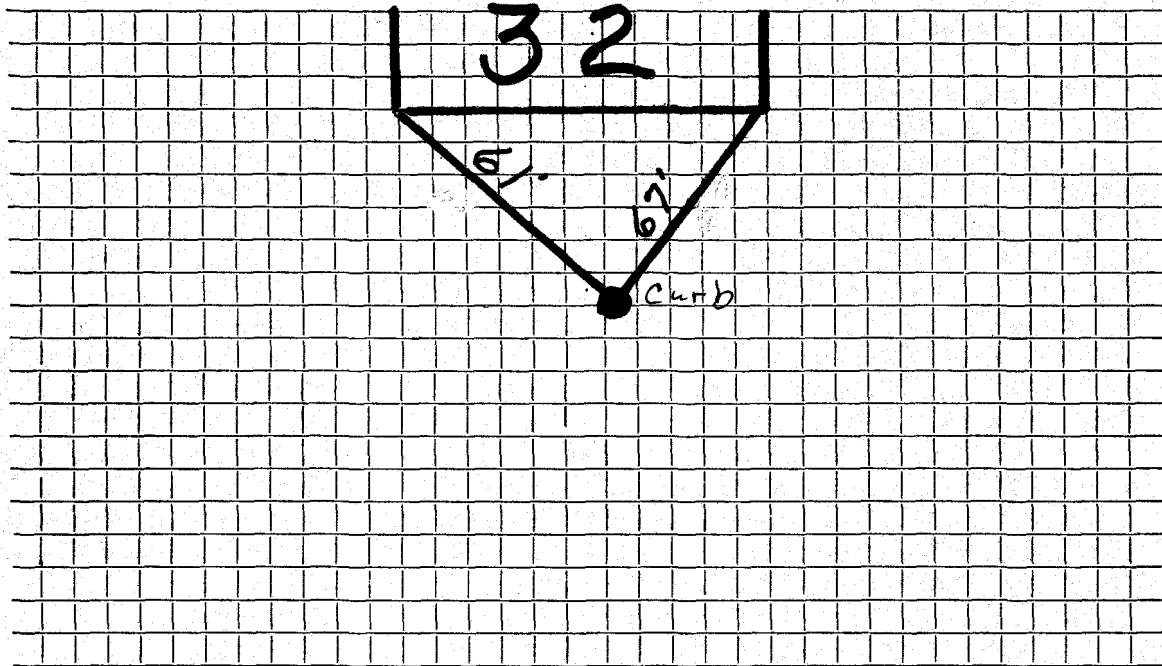

Connection made in Street. Work completed

Remarks:

.....

.....