

WATER SERVICE RECORD

Name Leeland Const. Co.

Service No. 170

Address 7 Roosevelt Road

Location

~~Repairs~~ Renewal - New Service

Cam. 8-30-54

Date	Material	Amount	Total	Date	Amount
7/22/54	Labor	1 85		7-16-54	Deposited 25 00
	10% overhead	19	2 04	9-14-54	Paid (11 51)
	80' - 3/4" copper tubing @ .35		28 00		<u>NON CHARGE</u> 36 51
	1 - 3/4"C x 1/2 I.W.H. stop & waste		4 00	7/22/54	Labor 5 05
	1 - 3/4"C x 3/4C. union		1 72	12' - 3/4" Copper tubing @ .35	4 20
	1 hr. trucking		75	1 - 3/4"C. corp-cock	4 33
			36 51	1 - 3/4"C. curb-cock	4 67
	trench dug by owner;			1 box and rod	3 90
				1 - 1/2 straight tail piece	50
				1 - 1/2 offset tail piece	50
				1 hr. trucking	75
					<u>23 90</u>


Bill sent 8-30-54

DATE _____

TOWN OF LEXINGTON — BOARD OF PUBLIC WORKS

WATER DIVISION

Sketch of Service Here

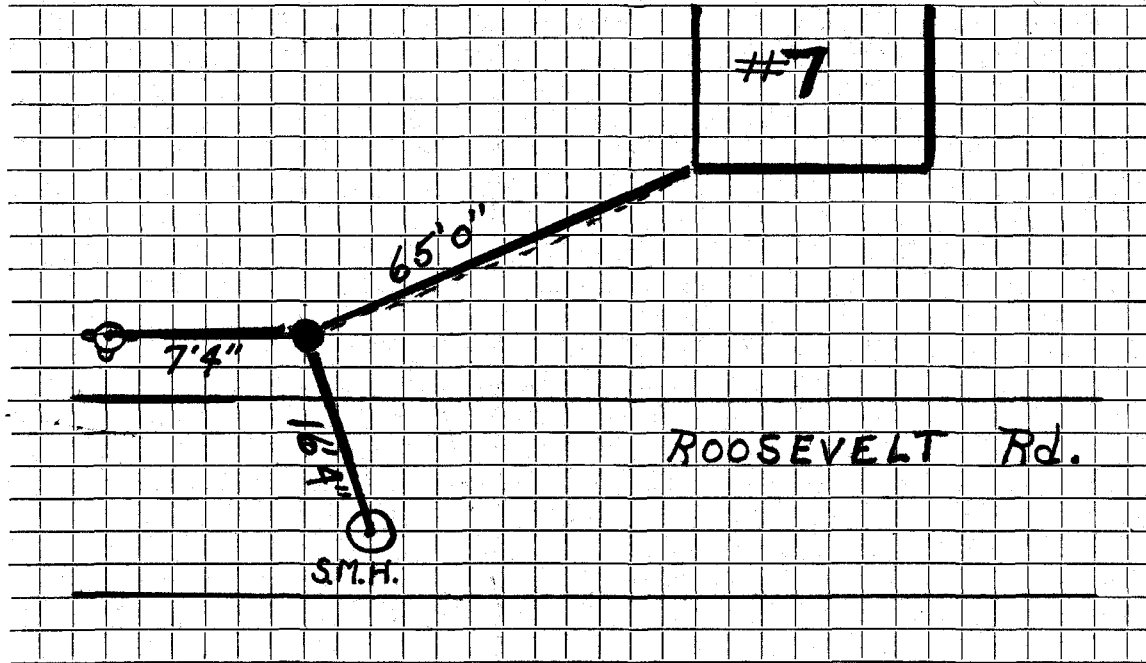

Connection made in Street. Work completed

Remarks:
.....
.....