

WATER SERVICE RECORD

Name Dianne Estates, Inc.

Service No. 2

Address 10 Ross Road Lexington 73, Massachusetts

#7048

Location


~~Repair~~ New Service

Cms 3-6-61

Date	Material	Amount	Total	Date	Amount	
3-1-61	Labor	3.74		4-10-61	Deposit	50.00
	10% O.H.	.37	4.11	5-6-61	Retained	12.11
60'	3/4" Copper tubing @.42		25.20			37.89
1	3/4" C x 1/2 I.W.H. Stop & Waste		6.17		NON CHARGE	
1	3/4" C 3 part union		2.41	8/7/58		
			37.89	25'	3/4" Copper Tubing @37	9.25
				1	3/4" C Copr Cock	4.64
				1	3/4" C Curb Cock	6.03
				1	Box & Rod	5.00
						24.92
					1 1/2 Straight tailpiece	.50
					1 1/2 Offset tailpiece	.50
						25.92

TOWN OF LEXINGTON — BOARD OF PUBLIC WORKS
WATER DIVISION

Sketch of Service Here

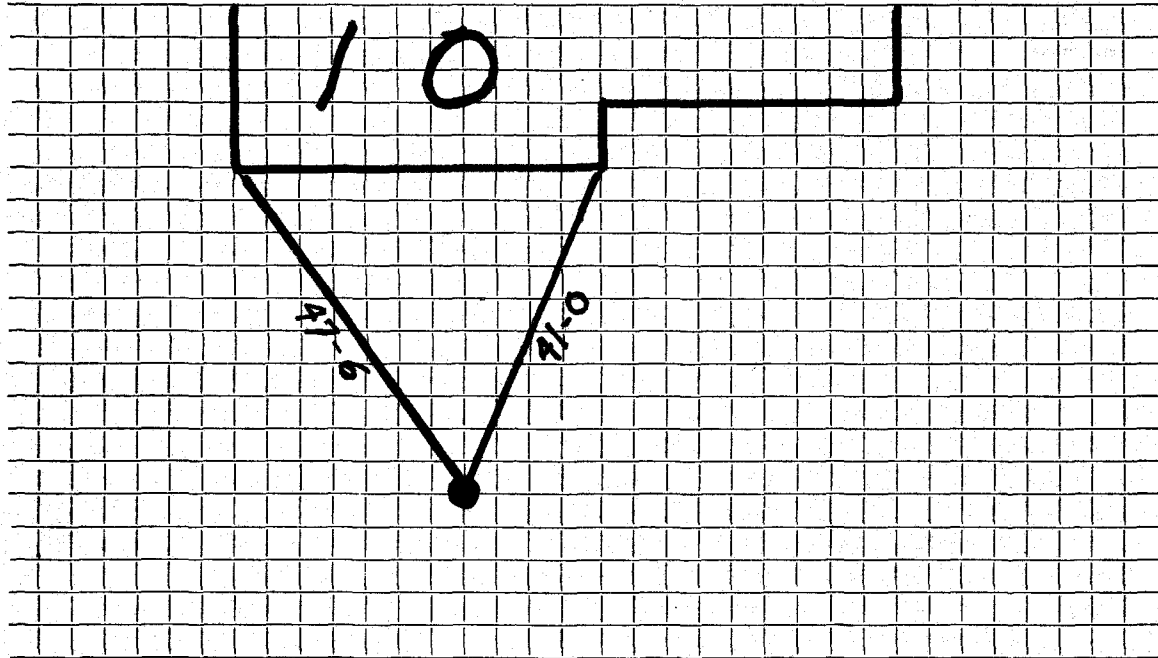

Connection made in Street. Work completed

Remarks:

.....

.....