

WATER SERVICE RECORD

Name Leeland Construction

2572
2573
Service No. 258

Address 11 Ross Road Lexington 73, Massachusetts

7215

Location

~~Repair~~ ~~Renewal~~ ~~New Service~~

Comm 3-13-58

Date	Material	Amount	Total	Date	Amount
11/25/58	Labor	3 70		11-14-58	Deposit
	10% overhead	37	4 07	3-13-59	Paid by SHC # 214
	105' - 3/4" Copper tubing @ .37	38 85	4 11 92	4-11-59	Paid
	1 - 3/4" Cx 1/2" I.W.H. Stop & Waste	5 84			NON CHARGE
	2 - 3/4" C. Unions (3 part) @ 2.27	4 54	4 54	8/7/58	
	1 hr. Trucking		75	30' 3/4" Copper Tubing @ 37	11 10
			54 05	1 3/4" C Corp Cock	4 64
				1 3/4" C Gurb Cock	6 03
				1 Box & Rod	5 00
					26 77


Bill sent 3-13-59 .9

DATE _____

TOWN OF LEXINGTON — BOARD OF PUBLIC WORKS

WATER DIVISION

Sketch of Service Here

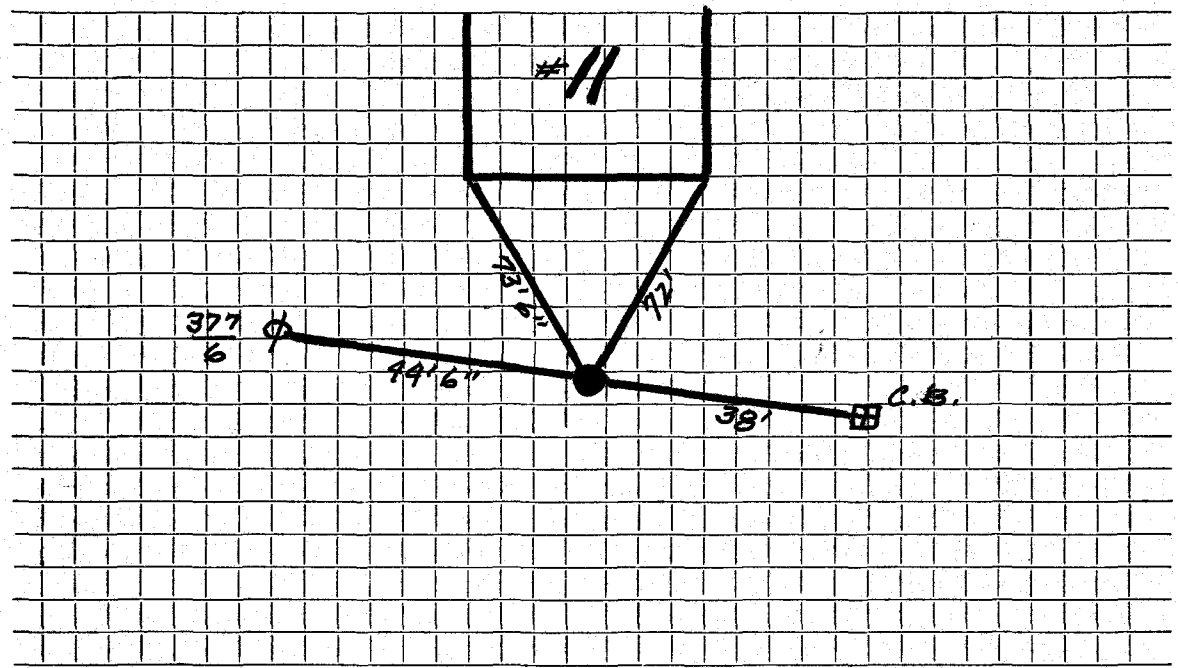

Connection made in Street. Work completed

Remarks:
.....
.....