

WATER SERVICE RECORD

Name **Michael Graziano**Service No. **141**Address **2 Ross Rd**

Location

~~Repair~~ ~~Repair~~ ~~Repair~~ **New Service***Com # 11-24-58*


Date	Material	Amount	Total	Date	Amount
7/28/58	Labor	3 70		7-16-58	50 00
	10% Overhead	37	4 07	11-24-58	17 11
	60'-3/4" Copper tubing @.37		22 20		32 86
	1-3/4" C x 1/2 IWH stop & waste		5 84		
	1 hr. Trucking @.75		75	7/28/58	3 70
			32 86		
				32'-3/4" Copper tubing @.37	11 84
				1-3/4" C Corp Cock	4 64
				1-3/4" C Curb Cock	6 03
				1 Box & Rod	5 00
				1-1/2" straight tail piece	50
				1-1/2" offset tailpiece	50
					<u>32 21</u>

DATE _____

TOWN OF LEXINGTON — BOARD OF PUBLIC WORKS

WATER DIVISION

Sketch of Service Here

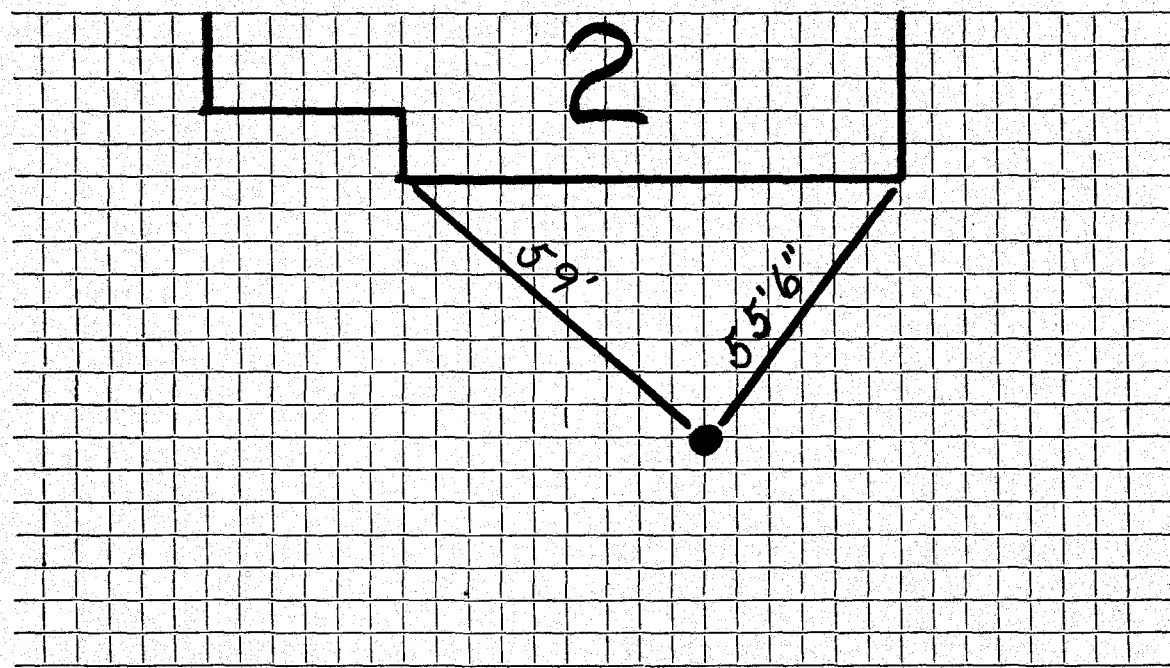

Connection made in Street. Work completed

Remarks:
.....
.....