


DATE 3/8/59

TOWN OF LEXINGTON — BOARD OF PUBLIC WORKS
WATER DIVISION

Sketch of Service Here

NO
#6

LOT
#33

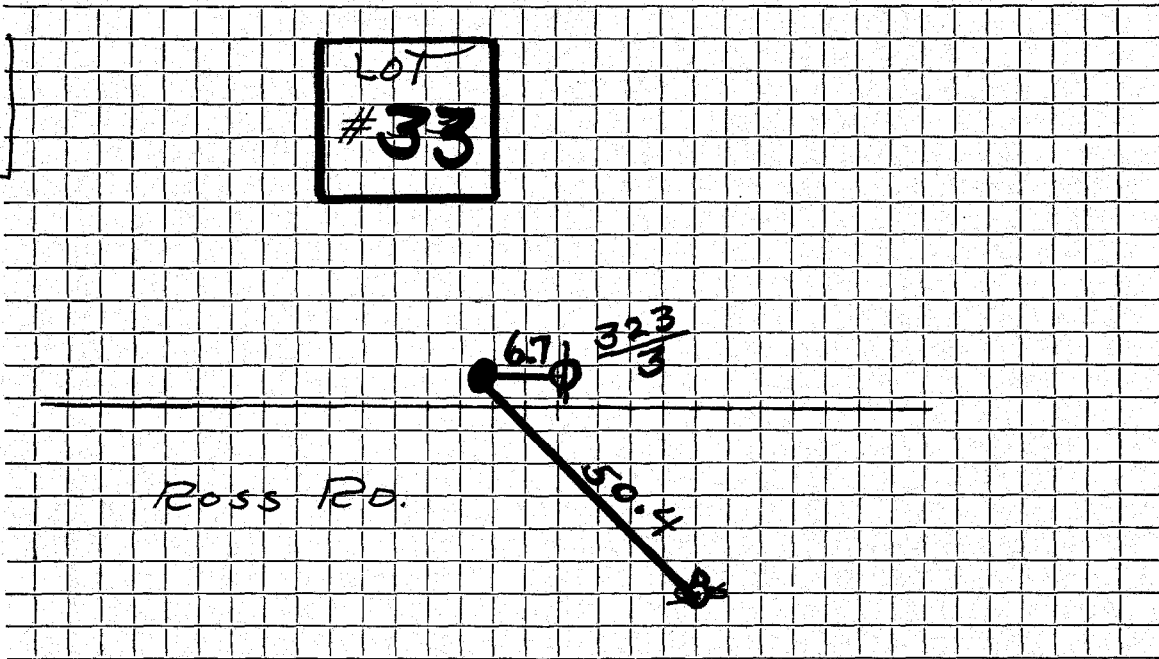

Connection made in ROSS RD. Street. Work completed

Remarks: SERVICE IN LOT NEXT TO NO. 6