

WATER SERVICE RECORD

Name Leeland Construction Company

Service No. 37

Address 7 Ross Road, Lexington, Massachusetts

Location Lot 20

~~Residence~~ New Service


Comm 10-14-58

Date	Material	Amount	Total	Date	Amount
5/1/58	Labor	3 90			35 00
	10% Overhead	39	4 29		8 31
	43' 3/4" Coppertubing @	37	15 91		26 79
	1 3/4" C x 1/2 I.W.H. Stop & Waste		5 84		NON CHARGE
	1 hr. Trucking @ 75		8 75	5/1/58	Labor
			26.79		15' 3/4" Copper tubing @ 37
					1 3/4" C Corp Cock
					1 3/4" C Curb Cock
					1 Box & Rod
					1 1/2 Straight tailpiece
					1 1/2 Offset tail piece
					<u>50</u>
					25.92

DATE _____

TOWN OF LEXINGTON — BOARD OF PUBLIC WORKS
WATER DIVISION

Sketch of Service Here

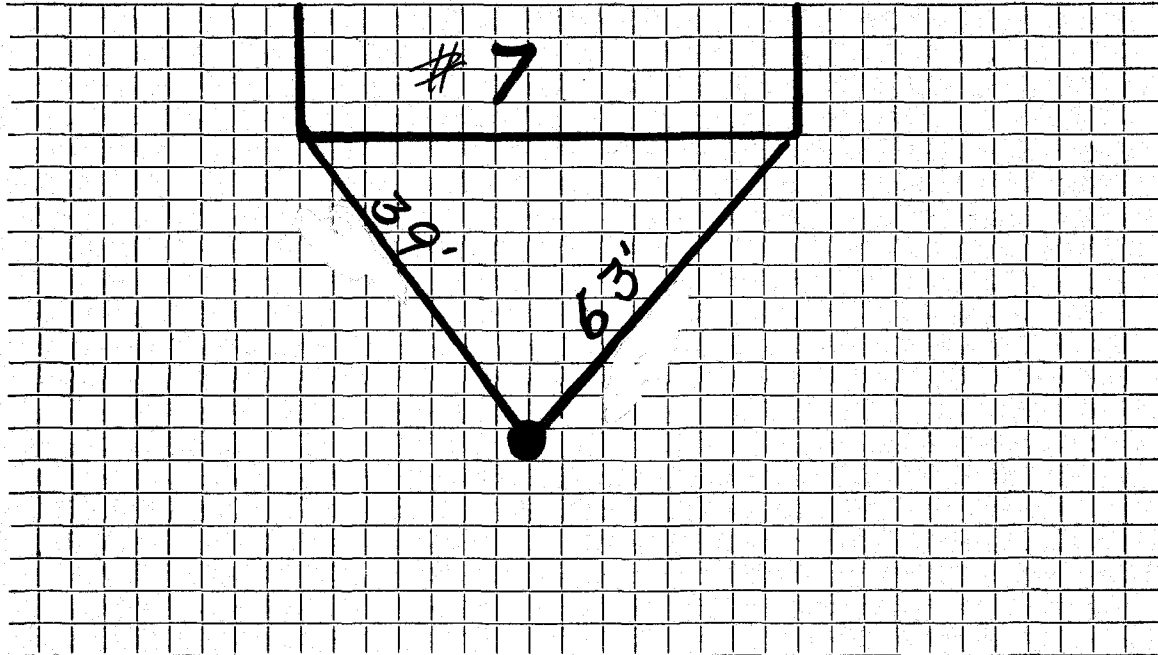

Connection made in Street. Work completed

Remarks:
.....
.....