

WATER SERVICE RECORD

Name Leeland Construction Company

Service No. 60

Address 9 Ross Road, Lexington 73, Massachusetts

Location Lot 19


~~Repair - Break~~ - New Service*Called 10-14-58*

Date	Material	Amount	Total	Date	Amount
4/30/58	Labor	3 70			10 00
	10% Overhead	37	4.07	10-14-58	17 36
	39' 3/4" Copper tubing @	37	14.43		27 36
	1 3/4" C x 1/2 I.W.H. Stopr & s W		5.84		
	13/4" C 3 part union		2.27		NON CHARGE
	1 hr. Trucking @	75	.75	4/30/58	Labor
			<u>27.36</u>		3.90
					16' 3/4" Copper tubing @ 37
					5.92
					1 3/4" C Corp Cock
					4.64
					1 3/4" C Curb Cock
					6.03
					1 Box & Rod
					5.00
					1 1/2 Straight tail piece
					.50
					1 1/2 Offset Tail piece
					.50
					<u>26.49</u>

DATE _____

TOWN OF LEXINGTON — BOARD OF PUBLIC WORKS
WATER DIVISION

Sketch of Service Here

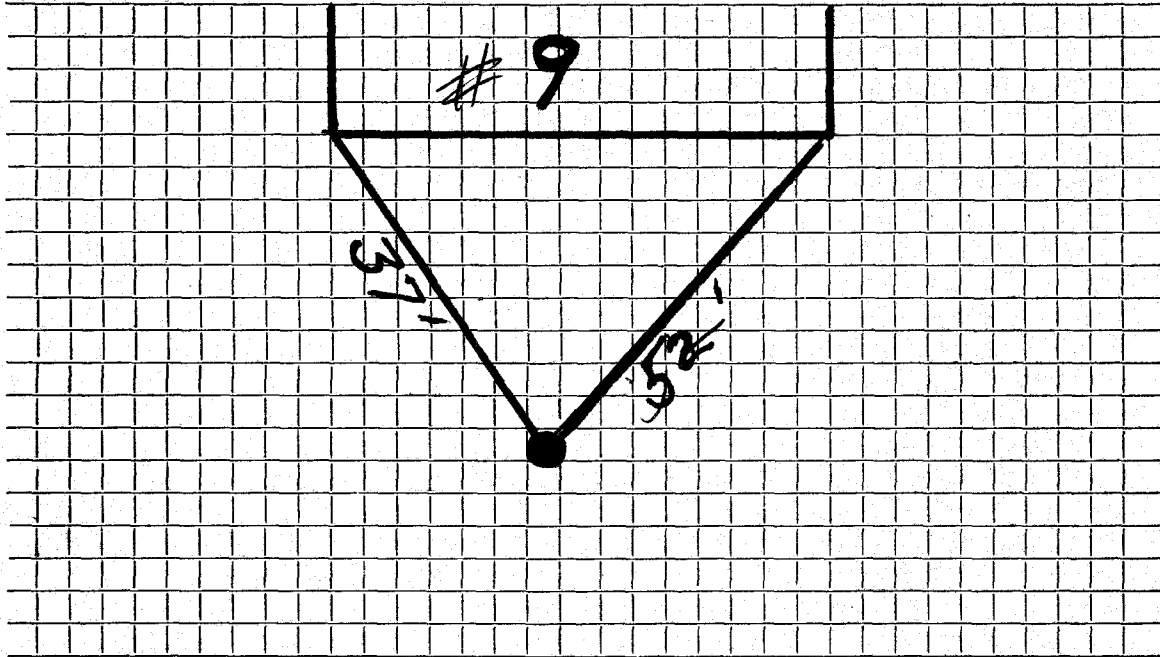

Connection made in Street. Work completed

Remarks:

.....

.....