

**WATER SERVICE RECORD**

Name *Richard Filipowski*

Service No.

Address *10 Round Hill Road*

Location

~~Repair~~—Renewal—~~New Service~~ *Redmond #4164*


Date	Material	Amount	Total	Date	Material	Amount
<i>4/21/83</i>	<i>205' 1" Copper tubing</i>					
	<i>3 1" Comp. Unions</i>					
	<i>1 Wheel Valve</i>					
					<i>OUTSIDE</i>	
				<i>5/22/83</i>	<i>51' 1" Copper tubing</i>	
					<i>1 1" Corporation</i>	
					<i>1 1" Curb</i>	
					<i>1 Box &amp; Rod</i>	
				<i>6/6/85</i>	<i>145' 1" Copper</i>	
					<i>1 1" Corporation</i>	
					<i>1 1" Curb</i>	
					<i>2 1" 3 Part Unions</i>	
					<i>1 Box &amp; Rod</i>	

DATE \_\_\_\_\_

TOWN OF LEXINGTON — BOARD OF PUBLIC WORKS

**WATER DIVISION**

Sketch of Service Here **#10 ROUND HILL**

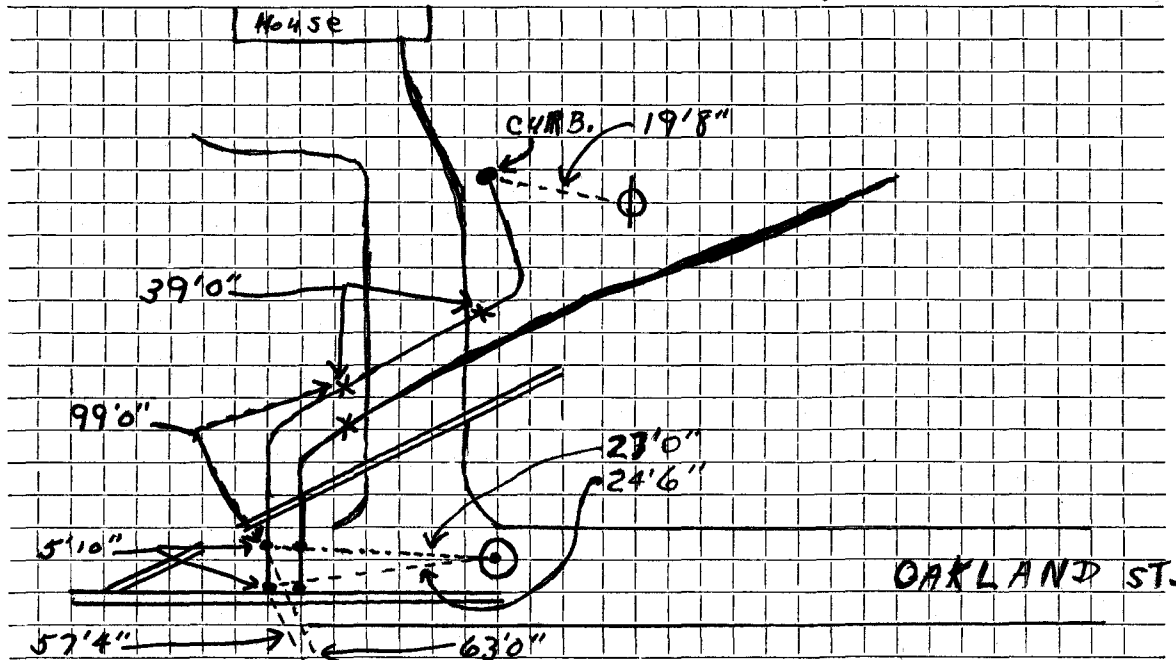

Connection made in ..... Street. Work completed .....

Remarks: .....

House