

WATER SERVICE RECORD

#6543

Name Harold Worth

Service No. 178

Address 16 Round Hill Rd.

Location

~~High Pressure~~ New Service


Com. 9-13-54

Date	Material	Amount	Total	Date	Amount
8/18/54	Labor	3 70		7-23-54 Deposited	100 00
	10% overhead	37	4 07	9-13-54 Refunded	(3 88)
	165' - 1" copper tubing@.4502	74 28			<u>NON CHARGE</u>
	1 - 1"C x 1" I.W.H. stop & waste	4 50		7/27/54 Labor	13 30
	2 - 1"C x 1"C. unions @ 2.26	4 52		6' - 1" copper tubing@.4502	2 70
	1 hr. trucking		75	1 - 1" C. corp-cock	5 61
	patching 8 x 3		8 00	1 - 1"C x 1"C. curb-cock	6 80
			96 12	1 box and rod	3 90
	TRENCH DUG BY OWNER:			1 - 1" straight tail pc.	93
				1 - 1" offset tail pc.	93
				2 hrs. Littlefield shovel@7.50	15 00
				1 hr. trucking	75
					49 92

TOWN OF LEXINGTON — BOARD OF PUBLIC WORKS

WATER DIVISION

Sketch of Service Here

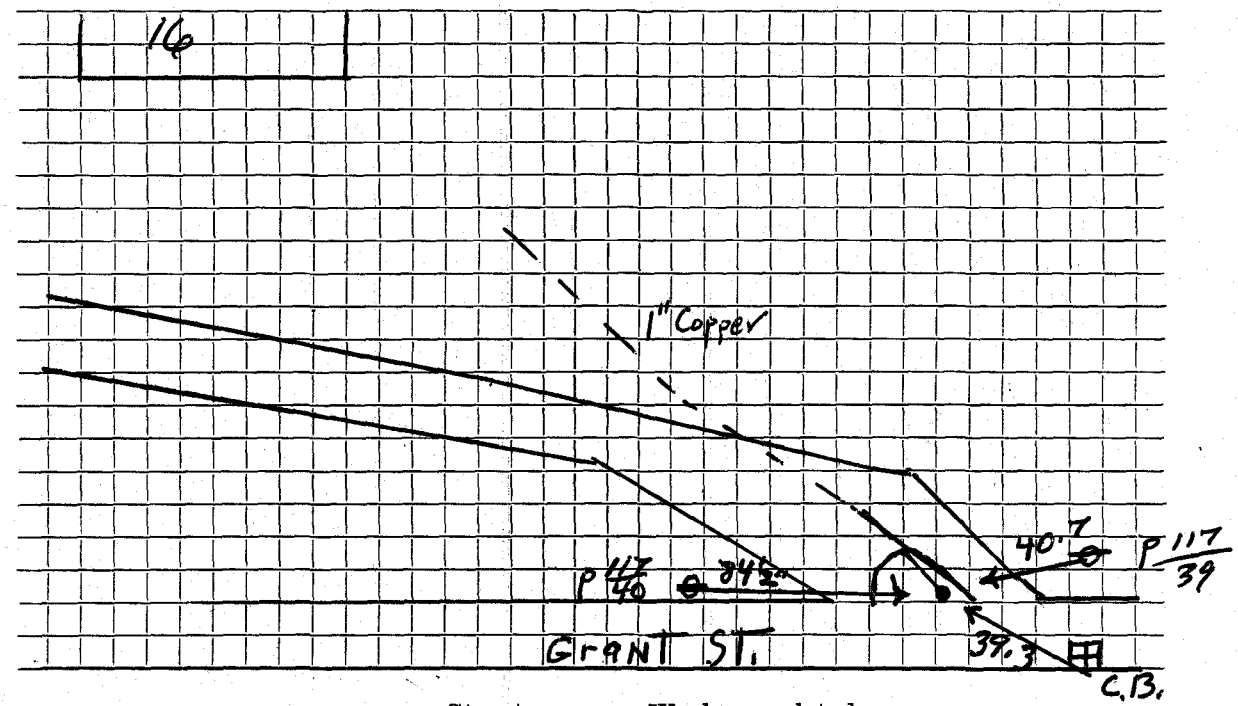

Connection made in ..... Street. Work completed .....

Remarks: .....  
.....  
.....