




DATE 9-12-1970

TOWN OF LEXINGTON — BOARD OF PUBLIC WORKS

WATER DIVISION

Sketch of Service Here

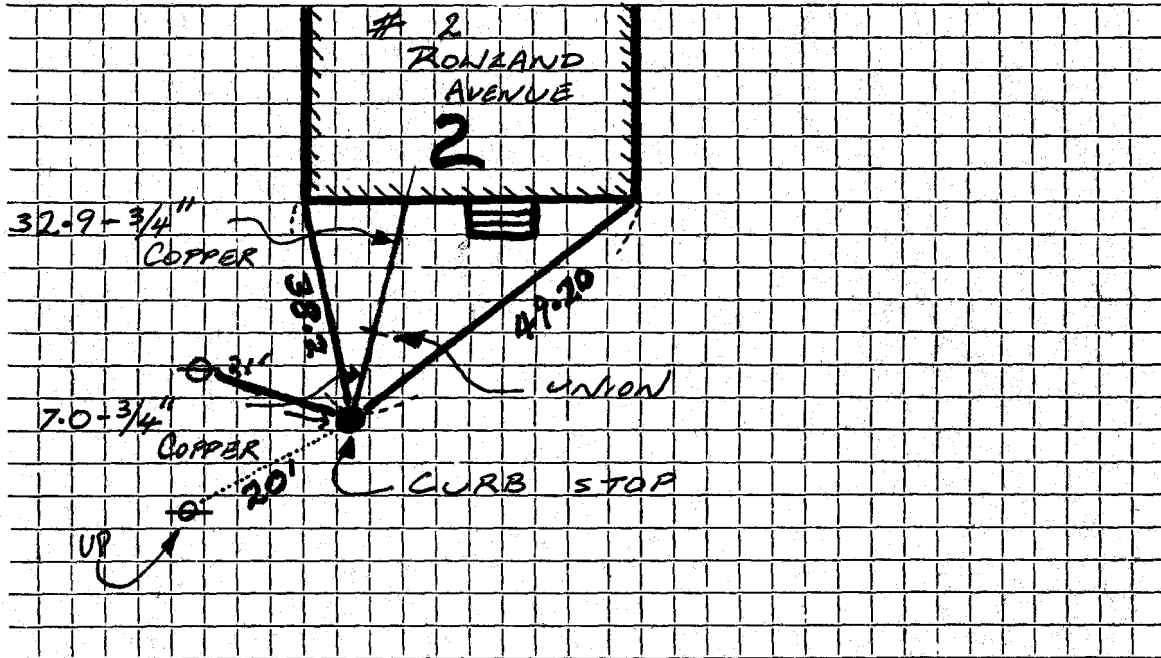

Connection made in RONLAND AVENUE Street.

Work completed .....

Remarks: .....  
.....  
.....