

Name John McNicholas

Service No. 164

Address 5 Rowland Avenue

Lexington, Mass.

Location 5 Rowland Avenue

Kind of Pipe

Size

Size of Main

~~Repair~~ ~~XXXXXX~~ - New Service

Location

Date	Material	Amount	Total	Date	Amount
Sept. 1, '48	Labor	1 15	1 15	Aug 25 '48	15 00
	10 % Overhead		12	Dec 31 '48	1 14
	43' - 3/4" Copper Tubing @ .255	10 97			16 14
	1 - 3/4" x 1/2" I.W.H. S & W	3 15			
	Trucking 1 hr. @ .75		75	Sept. 1, '48	1 15
			16 14	7' - 3/4" Copper Tubing @ .255	1 79
				1 - 3/4" Corp-cock	3 00
				1 - 2" I x 1 1/4" I. L. L. Tee	
				1 - 1 1/4" x 1" Bushing	20
				1 - 1" I x 3/4" C Union (2pts)	1 77
				2 - 2" Repair Clamps	2 46
				1 - Box & Rod	3 55
				1 - 1/2" Offset Tail Piece	30
	Labor			1 - 1/2" Straight Tail Piece	30
				Trucking 1 hr. @ .75	75

TOWN OF LEXINGTON - BOARD OF PUBLIC WORKS

**WATER DIVISION**

The undersigned applies for a supply of water at No..... St. and hereby agrees to comply with the rules and regulations as now, or at any future time, established by the Board of Selectmen.

Am't of Estimate \$.....

Owner .....


Am't Paid \$.....

Address .....

Builder .....

.....

Sketch of Service Here

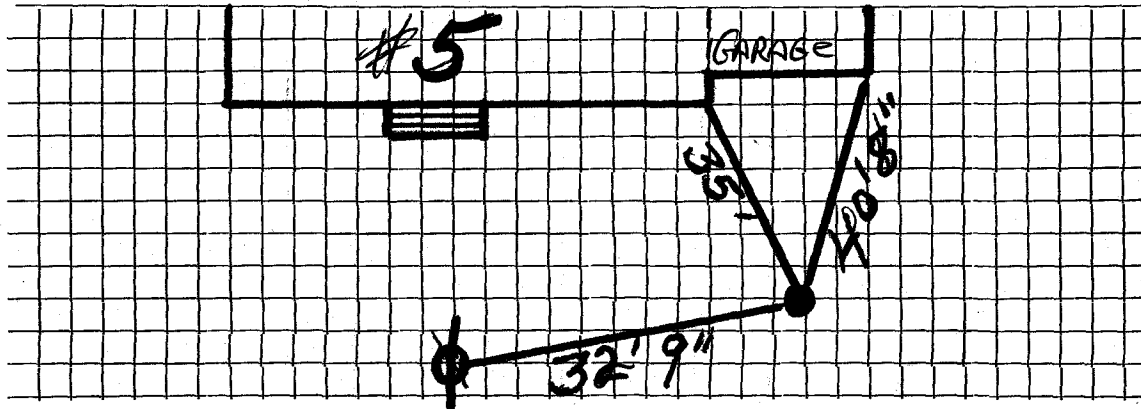

Connection made in ..... Street.

Work completed .....19

Remarks: