


DATE _____

TOWN OF LEXINGTON — BOARD OF PUBLIC WORKS
WATER DIVISION

Sketch of Service Here

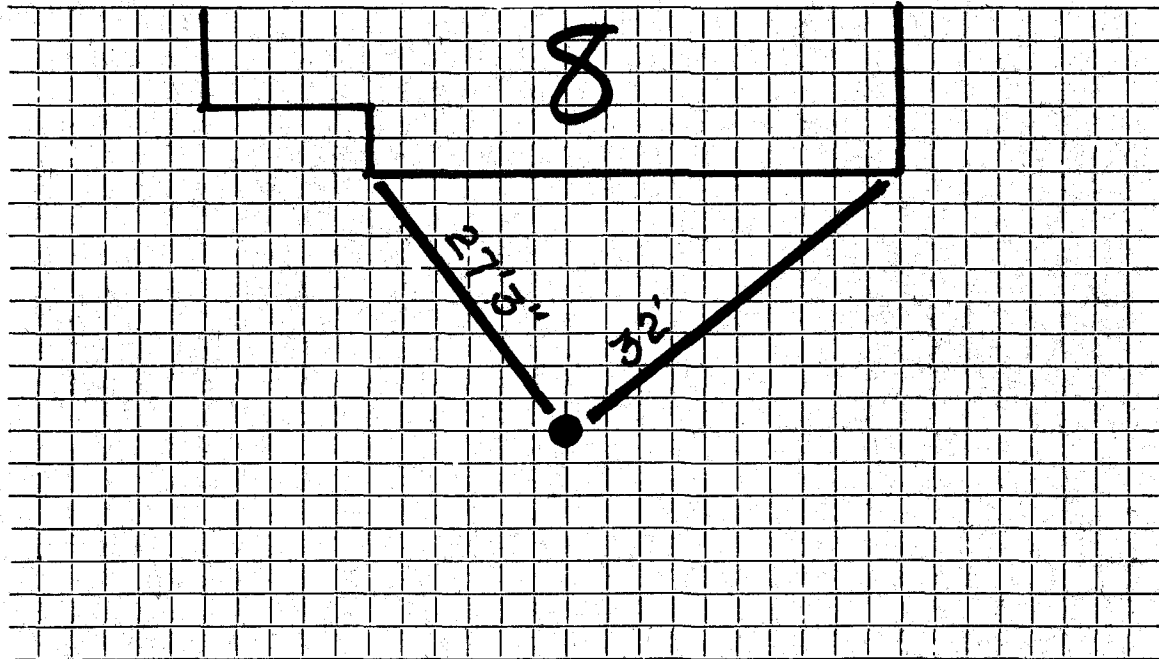

Connection made in Rowland AVE Street. Work completed 8-1-01

Remarks: installed by DAVID SANTOS