


TOWN OF LEXINGTON — BOARD OF PUBLIC WORKS

WATER DIVISION

RT 128

Sketch of Service Here

GAS STA. WATER FEEDS FROM ROY ROGERS

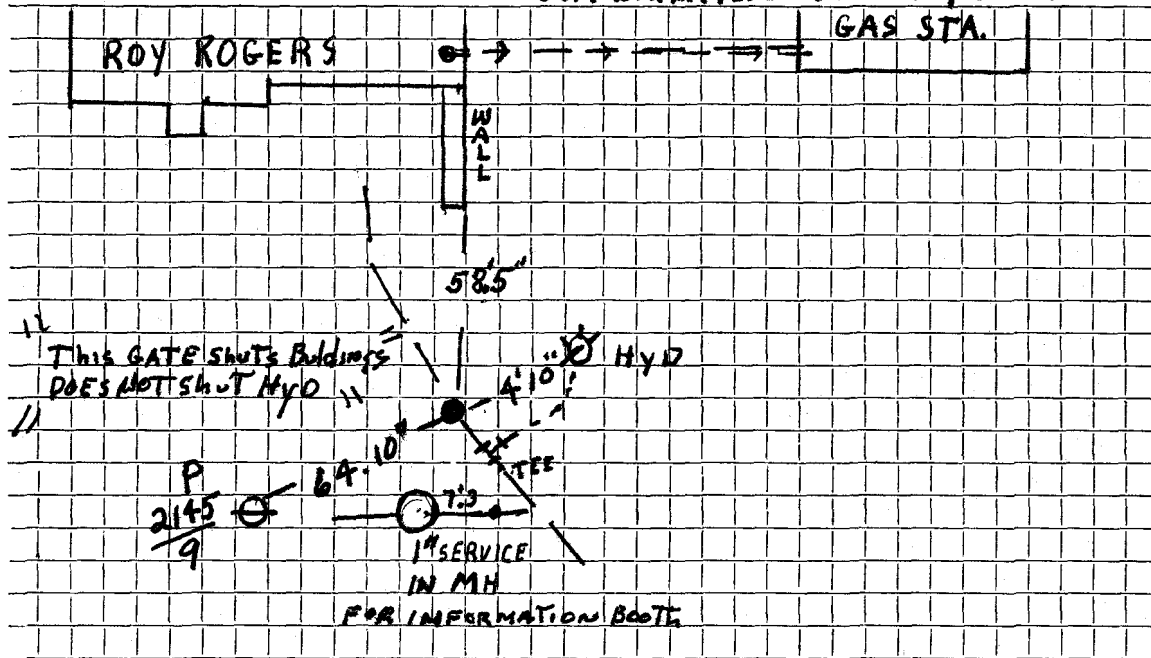

Connection made in Street. Work completed


Remarks: 4" MAIN FEEDS FROM BARRYMEADE DR. TIE BOOK NO. 44-4

TOWN OF LEXINGTON — BOARD OF PUBLIC WORKS

WATER DIVISION

Sketch of Service Here

6" To 4" FEED FROM BARRYMEAD DR.

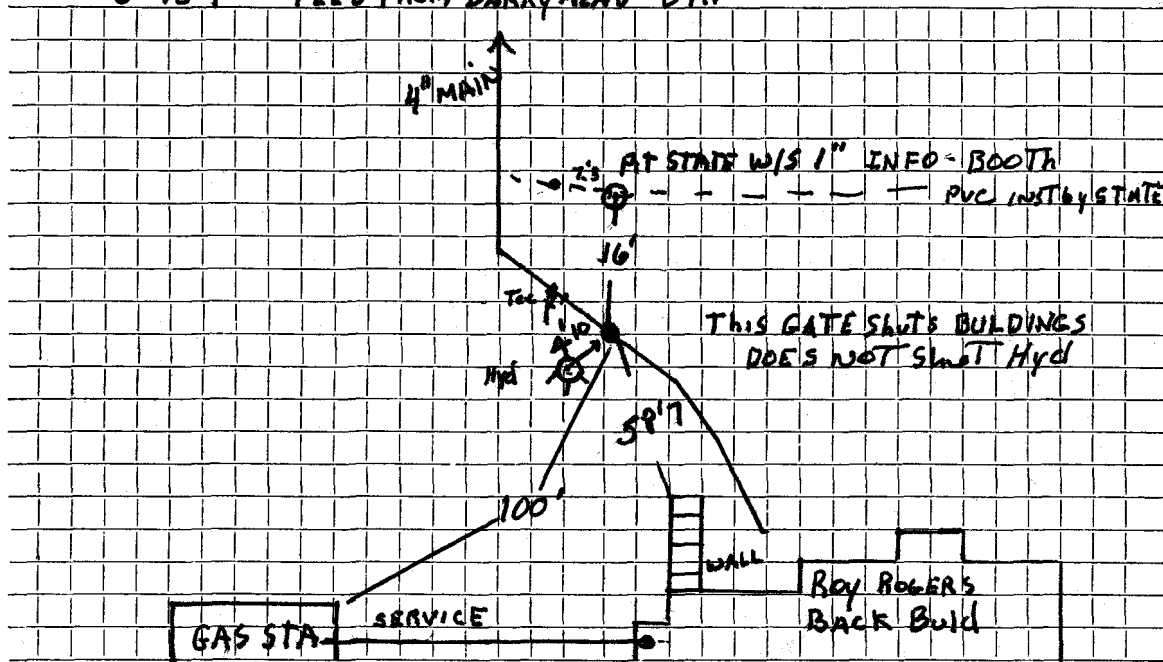

Connection made in Street. Work completed

Remarks: GAS STA. FEED FROM INSIDE ROY ROGERS