


DATE _____

TOWN OF LEXINGTON — BOARD OF PUBLIC WORKS

WATER DIVISION

3 LOT 6

Sketch of Service Here

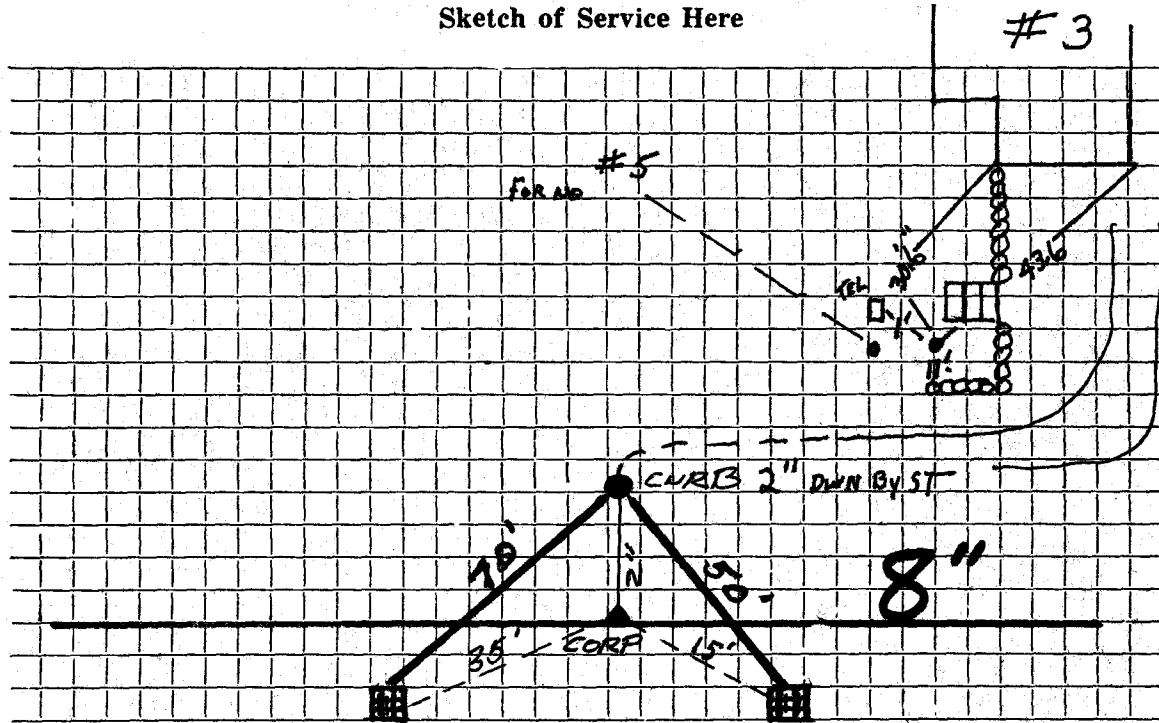

Connection made in ROYAL CIRCLE Street. Work completed

Remarks: 2" COPPER SERV. FEEDS NO 3 & 5