


TOWN OF LEXINGTON — BOARD OF PUBLIC WORKS

WATER DIVISION
5 LOT 5

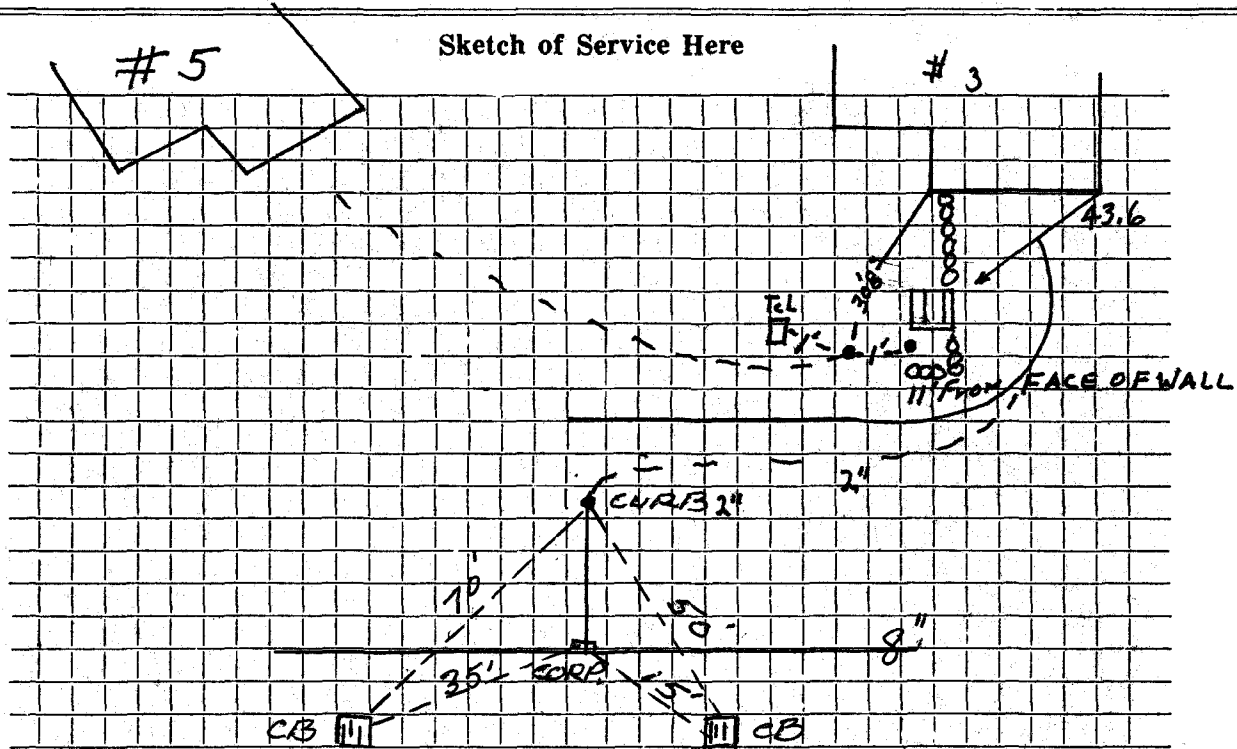

Connection made in ROYAL CIRCLE Street. Work completed

Remarks: 2" COPPER SERV. FEEDS NO #3 AND #5