


TOWN OF LEXINGTON — BOARD OF PUBLIC WORKS

WATER DIVISION

Sketch of Service Here

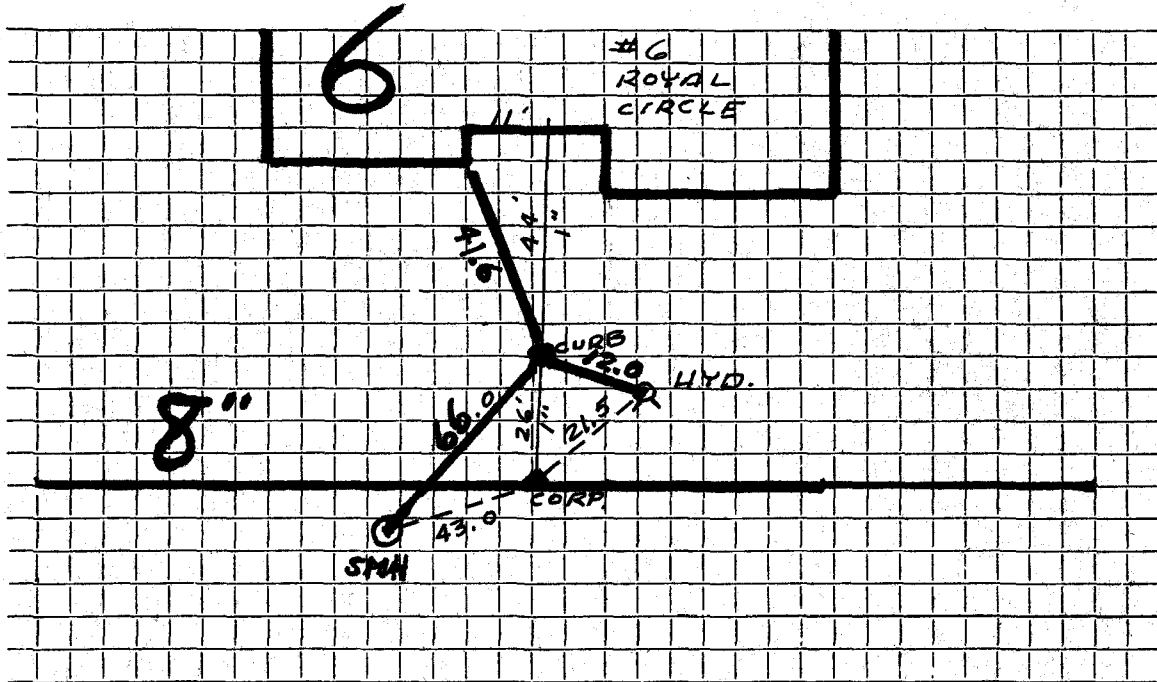

Connection made in ROYAL CIRCLE Street. Work completed

Remarks: M^CLAUGHLIN CONTR. I.S.
REDMOND CONTR. O.S.