

WATER SERVICE RECORD

Name *Barry Coyle*

Service No.

Address *7 ROYAL LIRLE*

Location *Lot 4*

Repair—Renewal—New Service *McLaughlin #0279*


Date	Material	Amount	Total	Date		Amount
<i>7/2/93</i>	<i>116 LF 1" COPPER</i>					
				<i>5-11-90</i>		
					<i>80' 1" Copper</i>	
					<i>1 1" C. Corp Cock</i>	
					<i>1 1" C. Curb Cock</i>	
					<i>Box + Rod</i>	

DATE 1/6/93

TOWN OF LEXINGTON — BOARD OF PUBLIC WORKS

WATER DIVISION

Sketch of Service Here

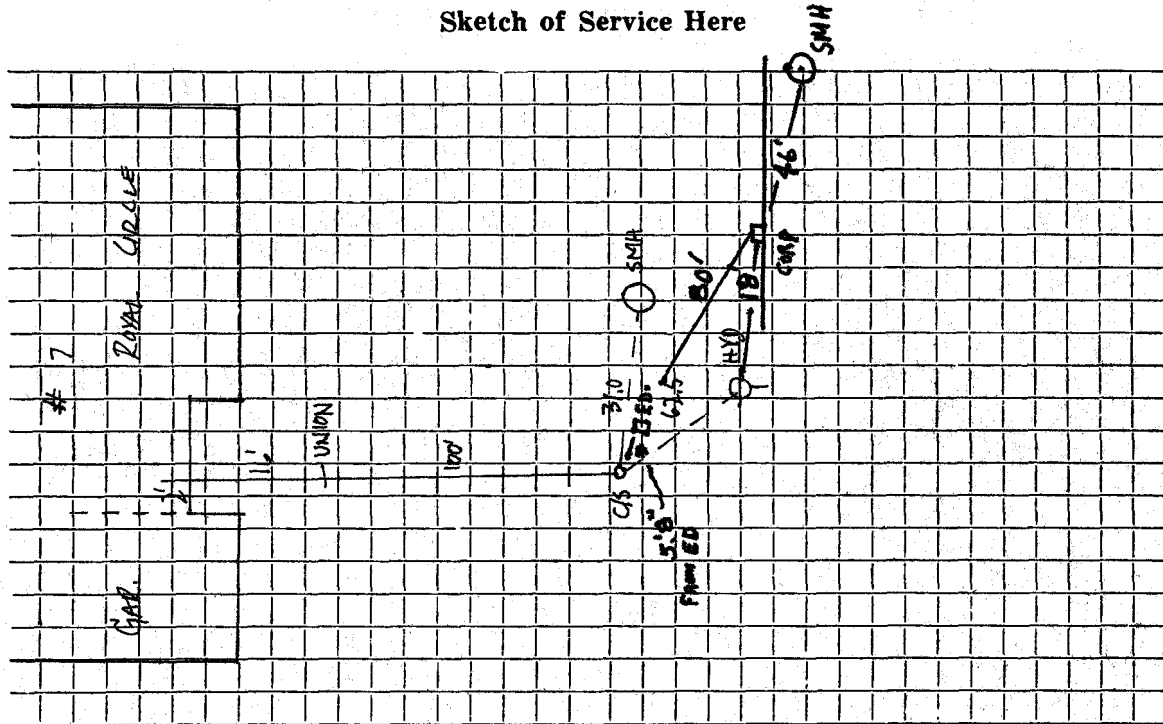

Connection made in Street. Work completed 1/21/93 J. McLAVALIN.....

Remarks: CURB BOX IS BEHIND EDISON BOX