


DATE _____

TOWN OF LEXINGTON — BOARD OF PUBLIC WORKS
WATER DIVISION

Sketch of Service Here

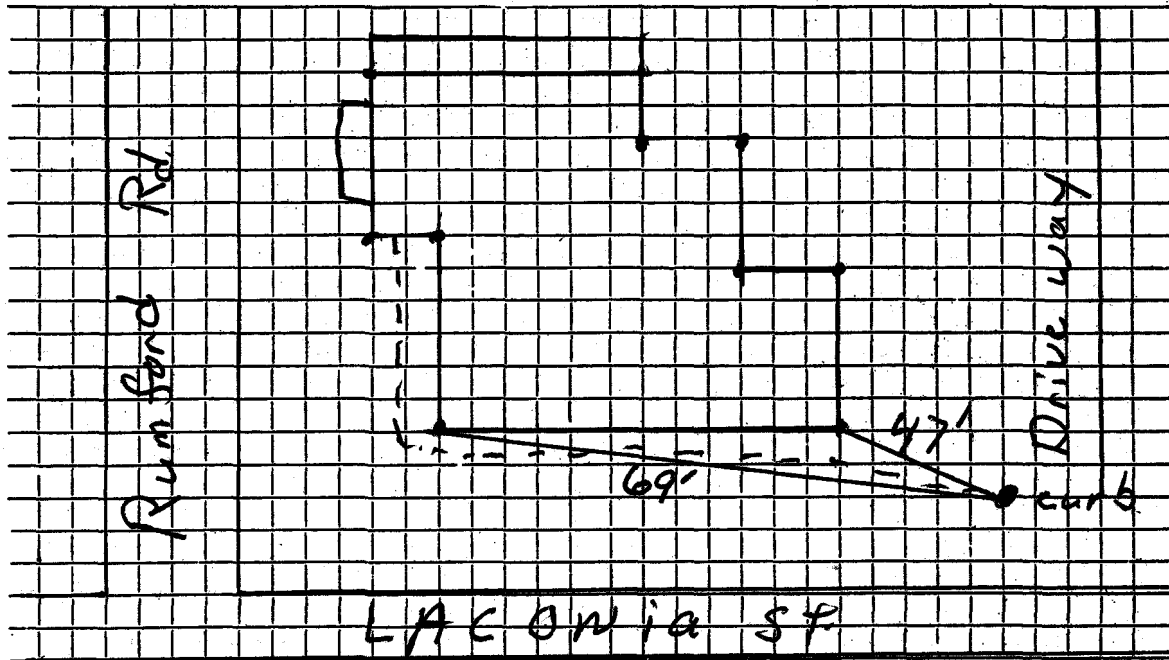

Connection made in Street. Work completed

Remarks:

100' - 1" copper

WATER SERVICE RECORD

Name

Service No.

Address

~~76 Laconia Street~~ NOW 24 RUMFORD RD.

Location

~~Repair—Renewal—New Service~~

W.O. #3204


Date		Material	Amount	Total	Date	REMOVED P.T	Amount
1927	2"	IRON			10/2/76	2' 1" COPPER	
						2 1" COMP. UNIONS	
						OUTSIDE (NON-CHARGE)	
					4-1-75	Labor 70.25	
					4-2-75	" 160.56	
					4-8-75	" 21.30	\$252.11
						10' 1" Copper Pipe	
						1 1" Curb Cock	
						1 BOX & Rod	
						1 2" x 1" Reducing Coupling	
						1 1" x 2" Nipple	
						1 2" Repair Clamp	
						1 1" Adapter	
						2 1" Copper to Iron Fittings	
						8 Yds. Gravel	
						4 Hrs. Trucking	
						4 Hrs. Backhoe	

DATE _____

TOWN OF LEXINGTON — BOARD OF PUBLIC WORKS

WATER DIVISION

Sketch of Service Here

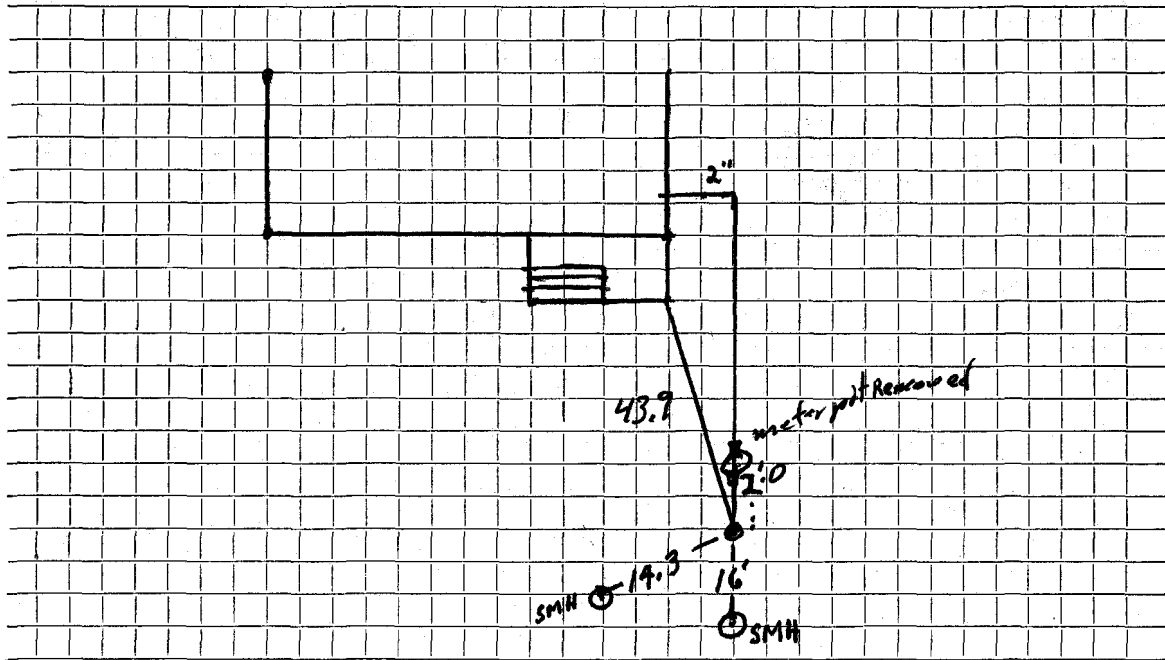

Connection made in Street. Work completed

Remarks: 10/2/96 METER P.I.T. Removed. 1ST UNION 2' FROM CURB STOP.