

WATER SERVICE RECORD

Name Benjamin Franklin Homes

Service No. 275

Address 4 Rumford Road

Location Lot 21

~~XXXXXXXXXXXX~~ - New Service

Comm - 3-16-59


Date	Material	Amount	Total	Date	Amount
12-5-58	Labor	1.77		12-5-58	75.00
	10% O.H.	.18	1.95	3-16-59	47.94
50'	3/4" Copper tubing @.37		18.50		27.84
1	3/4" Cx 1/2 I.W.H. Stop & Waste		5.84		NON CHARGE
1	hr. Trucking @.75		.75	10/9/57	4.88
			27.04	23' 3/4" Copper tubing	8.63
				1 3/4" C Corp Cock	4.64
				1 3/4" C Curb Cock	5.94
				1 Box & Rod	4.62
				1 Hour Trucking @ .75	75
					29.46
				1 1/2 Straight tailpiece	.50
				1 1/2 Offset tailpiece	.50
					30.46

DATE _____

TOWN OF LEXINGTON — BOARD OF PUBLIC WORKS

WATER DIVISION

Sketch of Service Here

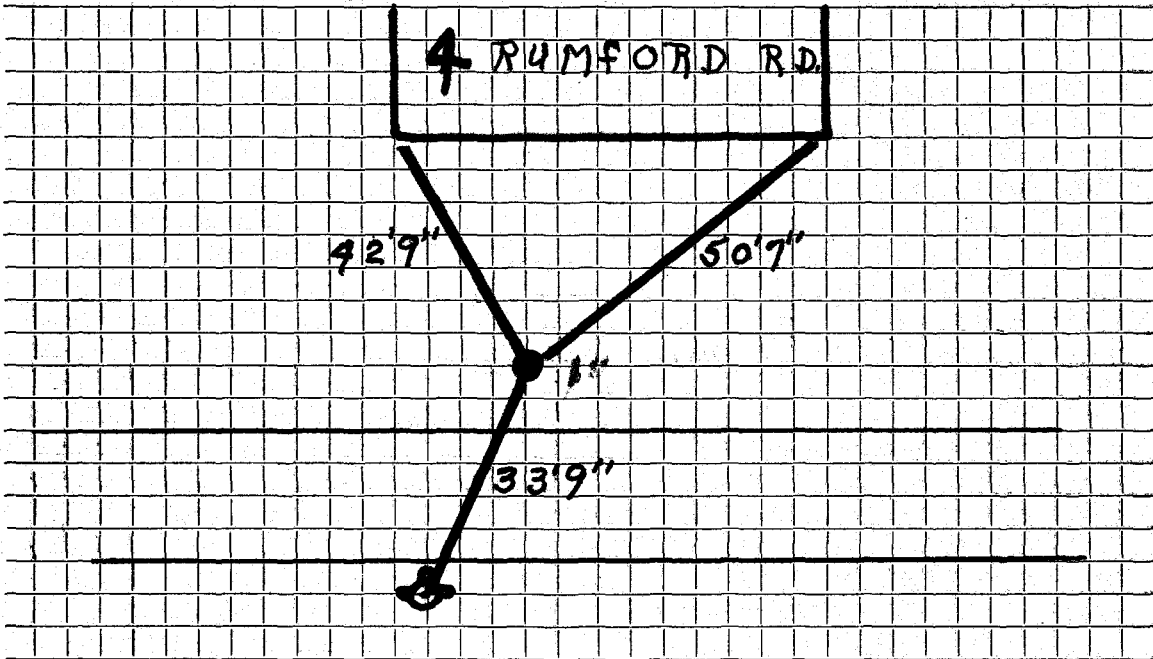

Connection made in Street. Work completed

Remarks:

.....

.....