




DATE 5/11/18

TOWN OF LEXINGTON — BOARD OF PUBLIC WORKS

WATER DIVISION

Sketch of Service Here

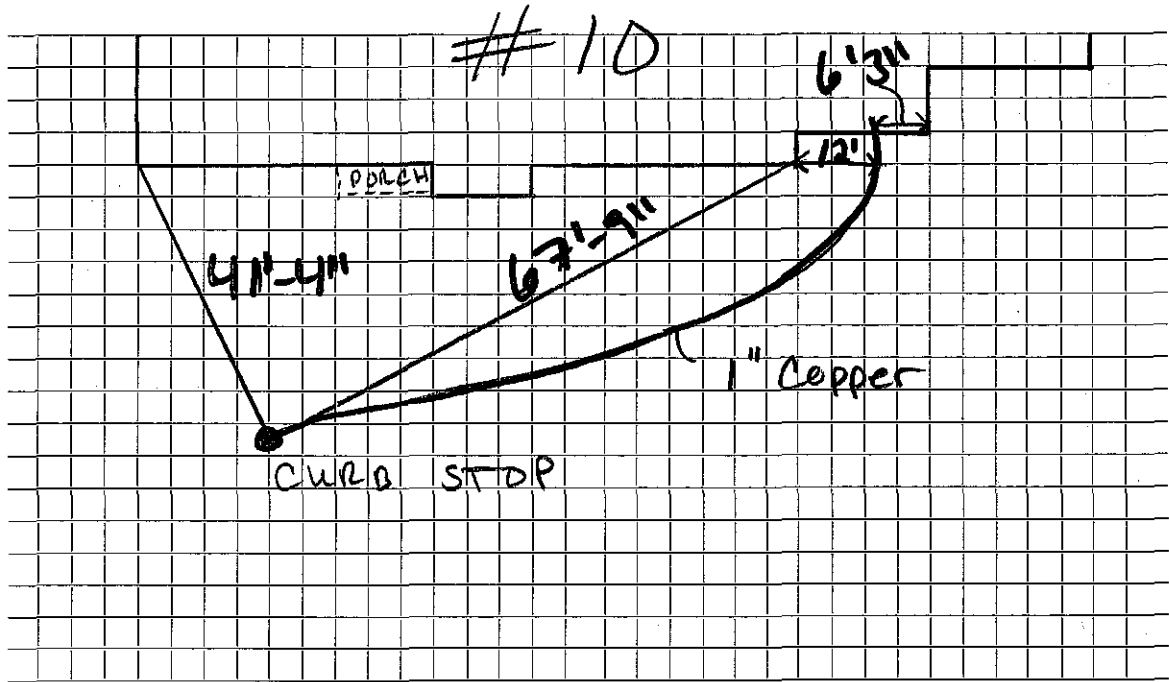

Connection made in Russell Rd Street. Work completed .....

Remarks: ties taken from JM McLaughlin's Ties