

WATER SERVICE RECORD

6414

Name DeVries Construction Company

Service No. 40 N.D.

Address 11 Russell Road

Location

~~Repair~~ ~~Renewal~~ New Service

Comm. 4/1/57

Date	Material	Amount	Total	Date	Amount
11-26-56	Labor	1.95		10-21-57	Paid \$ 7.86
	10% O.H.	.20	2.15		
	(Owner's Copper)				
	1 3/4" C x 1/2 I.W.H. Stop & Waste		4.96		NON CHARGE
	1 Hr. Trucking @.75		.75		Labor 1.95
			7.86		12' 3/4" Copper Tubing @.4396 5.28
					1 3/4" C Corp Cock 4.64
					1 3/4" C Curb Cock 5.94
					1 Box & Rod 4.62
					1 1/2 Straight Tail Piece .50
					1 1/2 Offset Tail Piece .50
					23.43


Bill sent 4/3/57

DATE _____

TOWN OF LEXINGTON — BOARD OF PUBLIC WORKS

WATER DIVISION

Sketch of Service Here

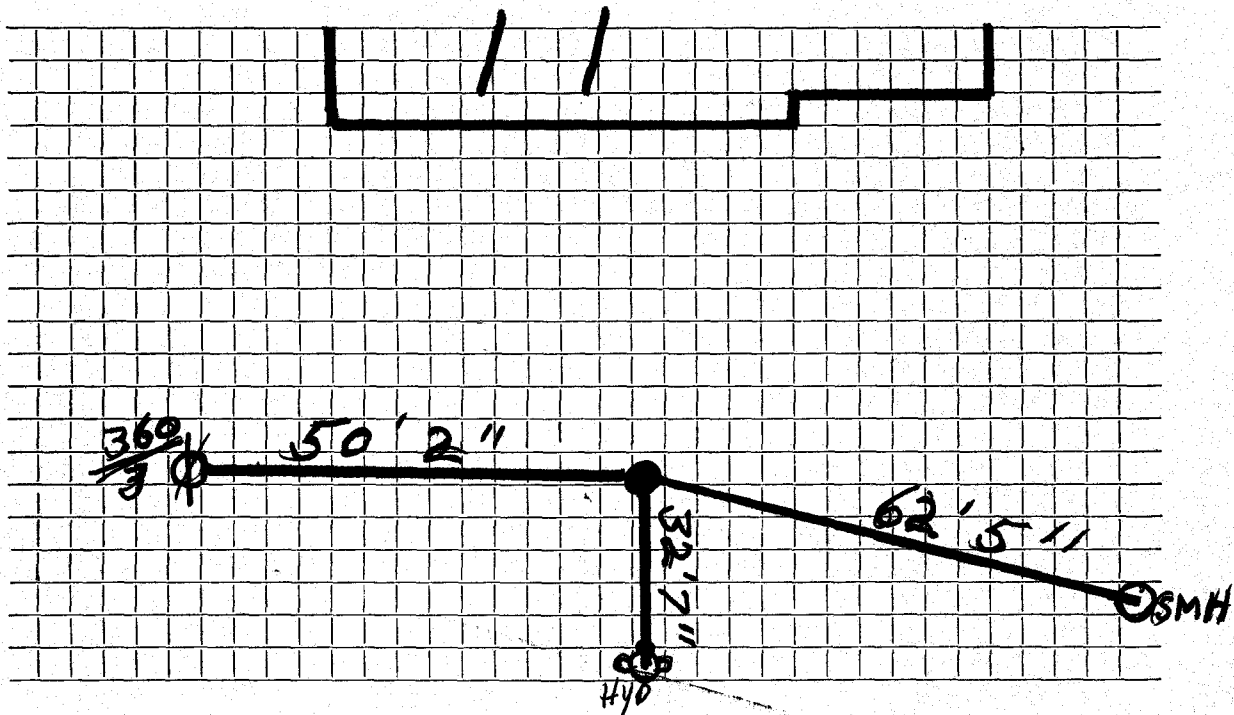

Connection made in Street. Work completed

Remarks:

.....
.....