

WATER SERVICE RECORD

Name DeVries Construction Company

Service No. 111 N.D.

Address 111 Russell Road

3454

Location

~~Renewal~~ New Service

Comm. 4/1/57

Date	Material	Amount	Total	Date	Amount
11-26-56	Labor	1.95		10-21-57 Paid	\$ 7.86
	10% O.H.	.20	2.15		
	(Owner's Copper)				
1	3/4" C x 1/2 I.W.H. Stop & Waste		4.96		NON CHARGE
1	hr. Trucking @.75		<u>.75</u>		Labor
			7.86		24' 3/4" Copper tubing @.4396
					10.55
					1 3/4" C Corp Cock
					4.64
					1 3/4" C Curb Cock
					5.94
					1 Box & Rod
					4.62
					1 1/2 Straight Tail Piece
					.50
					1 1/2 Offset Tail Piece
					<u>.50</u>
					28.70


Bill sent 4/3/57

DATE _____

TOWN OF LEXINGTON — BOARD OF PUBLIC WORKS

WATER DIVISION

Sketch of Service Here

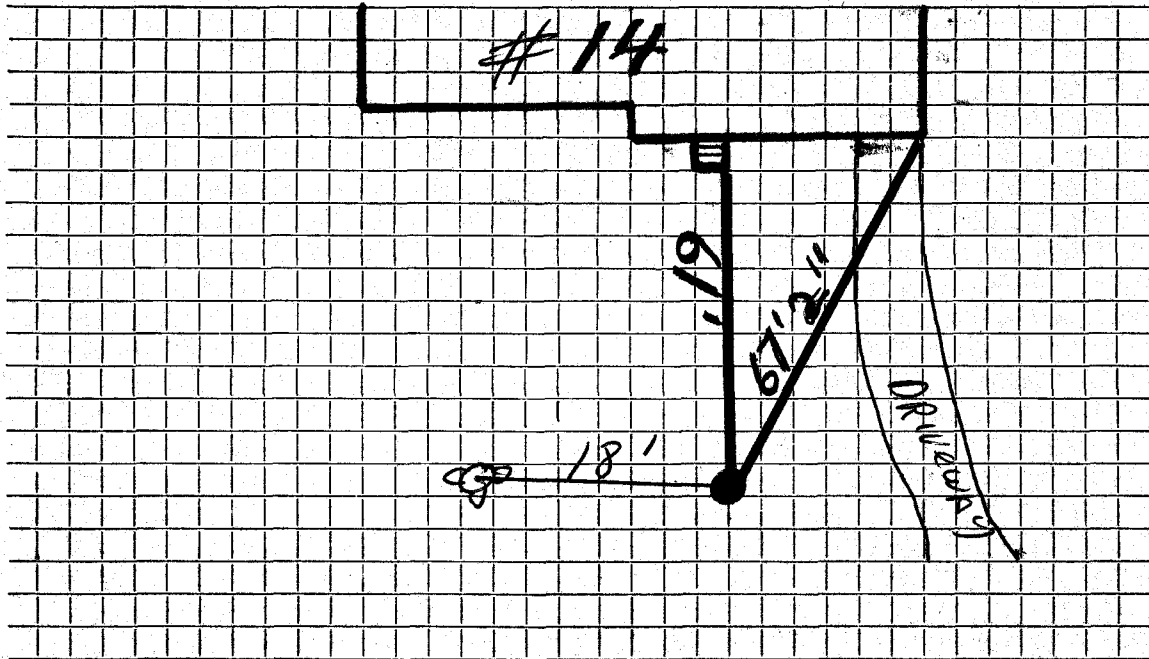

Connection made in Street. Work completed

Remarks:

.....

.....