

## WATER SERVICE RECORD

Name DeVries Const. Co.

Service No. 42 N. D.

Address 15 Russell Road

Location

~~Repair~~ New Service

Comm. 4/1/57


Date	Material	Amount	Total	Date	Amount
11-26-56	Labor	1.95		10-27-57 Paid	7.86
	-10% O.H.	.20	2.15		
	(Owners Copper)				
	1 3/4" C x 1/2 I.W.H. Stop & Waste		4.96		NON CHARGE
	1 hr. Trucking @.75		.75		Labor
			7.86		31' 3/4" Copper tubing @.41396
					1 3/4" C Corp Cock
					1 3/4" C Curb Cock
					1 Box & Rod
					1 1/2 Straight Tail Piece
					1 1/2 Offset Tail Piece
					31.78

DATE \_\_\_\_\_

TOWN OF LEXINGTON — BOARD OF PUBLIC WORKS

WATER DIVISION

Sketch of Service Here

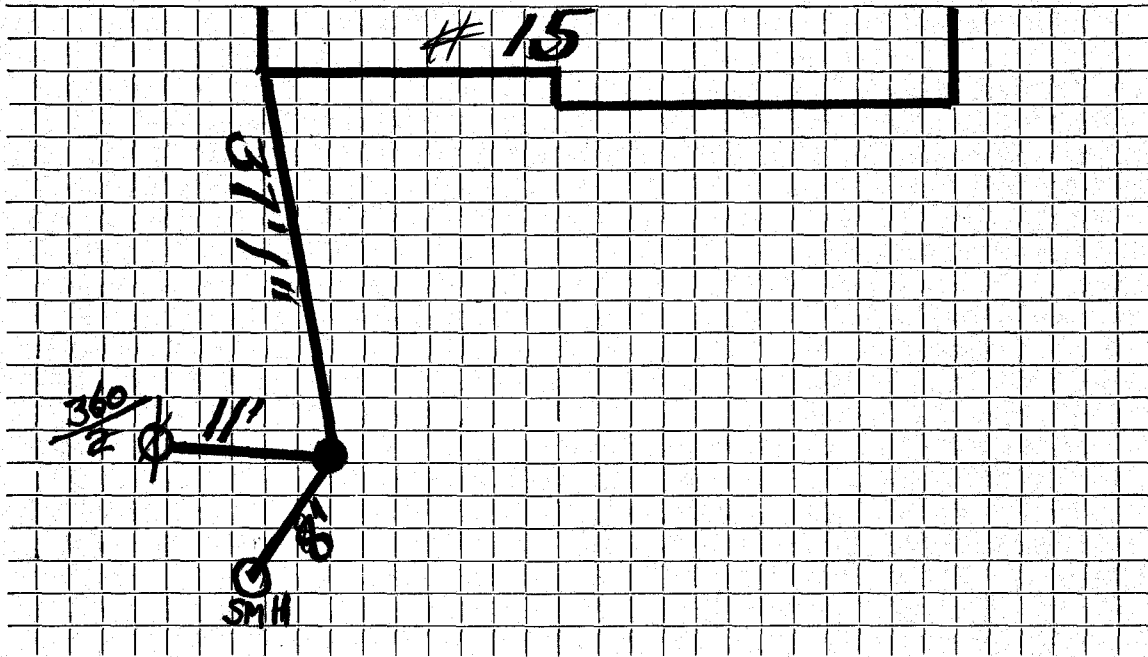

Connection made in ..... Street. Work completed .....

Remarks: .....

.....

.....