

WATER SERVICE RECORD

Name DeVries Construction Co. Service No. 44 N.D.
 Address 17 Russell Road
 Location _____
~~Repair - Renewal~~ New Service *Comm. 4/1/57*


Date	Material	Amount	Total	Date		Amount
11-26-56	Labor	1.95		<i>10-21-57</i>	<i>PAID</i>	<i>\$7.86</i>
	10% O.H.	.20	2.15			
	(Owner's Copper)					
	1 3/4" C x 1/2 I.W.H. Stop & Waste		4.96		NON CHARGE	
	1 hr. Trucking @.75		<u>.75</u>		Labor	1.95
			<u>7.86</u>		15' 3/4" Copper tubing @.4396	6.59
					1 3/4" C Corp Cock	4.64
					1 3/4" C Curb Cock	5.94
					1 Box & Rod	4.62
					1 1/2 Straight Tail Piece	.50
					1 1/2 Offset Tail Piece	<u>.50</u>
						<u>24.74</u>
					<i>Bill sent 4/3/57</i>	

DATE _____

TOWN OF LEXINGTON — BOARD OF PUBLIC WORKS

WATER DIVISION

Sketch of Service Here

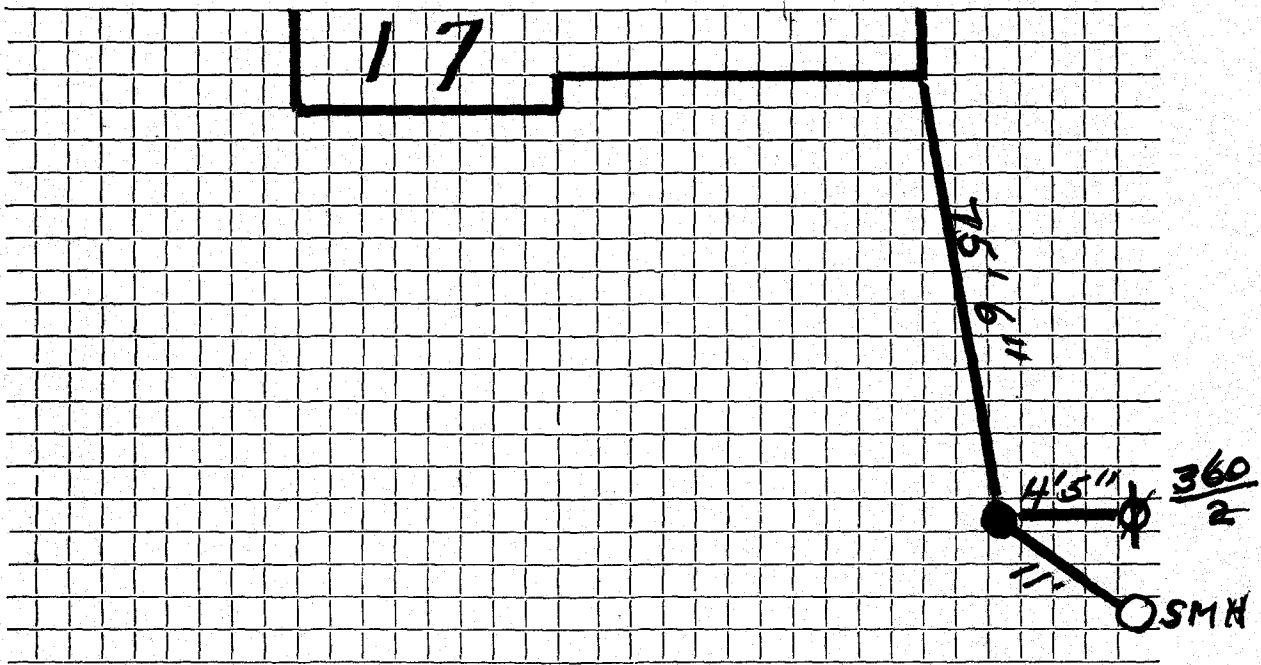

Connection made in Street. Work completed

Remarks:
.....
.....