


DATE _____

TOWN OF LEXINGTON — BOARD OF PUBLIC WORKS

WATER DIVISION

Sketch of Service Here

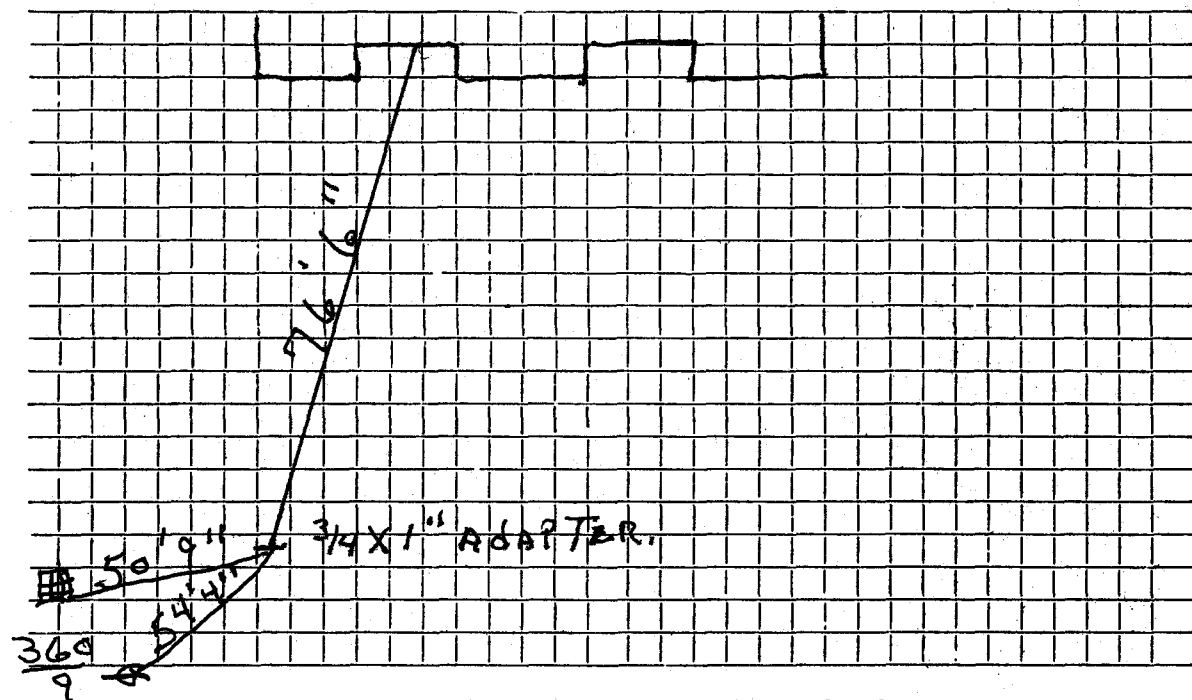

Connection made in Street. Work completed

Remarks:

.....

.....

WATER SERVICE RECORD

Name DeVries Construction

Service No. 34 N.D.

Address 1/4 Russell Road

3451

Location

~~Repair - Renewal~~ - New Service

Comm. 4/1/57

Date	Material	Amount	Total	Date	Amount
11-26-56	Labor	1.95		10-21-57	PAID # 7.86
	10 % O.H.	.20	2.15		
	(Owners Copper)				
1	3/4" C x 1/2 I.W.H. Stop & Waste		4.96		NON CHARGE
1	hr. Trucking @ .75		.75		Labor
			7.86		1.95
					18' 3/4" Copper tubing @ .4396
					7.92
					1 3/4" C Corp Cock
					4.64
					1 3/4" C Curb Cock
					5.94
					1 Box & Rod
					4.62
					1 1/2 Straight tail piece
					.50
					1 1/2 Offset tail piece
					.50
					26.07


Billsent 4/6/57

DATE _____

TOWN OF LEXINGTON — BOARD OF PUBLIC WORKS

WATER DIVISION

Sketch of Service Here

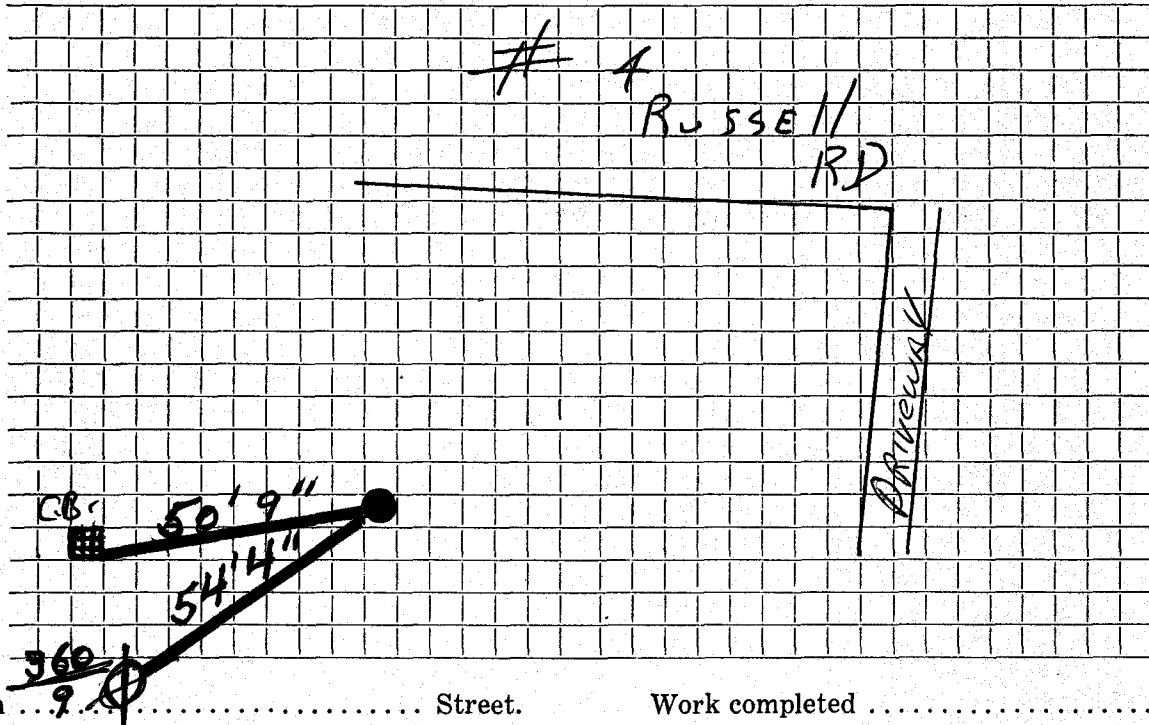

Connection made in 9 Street. Work completed

Remarks:
.....
.....