

## WATER SERVICE RECORD

Name DeVries Construction Company

Service No. 35 N.D.

Address 5 Russell Road

Location

~~Repair~~ ~~Renewal~~ New Service

Comm. 4/1/57


Date	Material	Amount	Total	Date	Amount
11-26-56	Labor	1.95		10-21-57 Paid	\$ 786
	10% O.H.	.20	2.15		
	(Owner's Copper)				
1	3/4" C x 1/2 I.W.H. Stop & Waste		4.96		NON CHARGE
1	hr. Trucking @ .75		.75		Labor
			7.86		10' 3/4" Copper tubing @ .4396
					1 3/4" C Corp Cock
					1 3/4" C Curb Cock
					1 Box & Rod
					1 1/2 Straight tail piece
					1 1/2 Offset tail piece
					22.55

Bill sent 4/3/57

TOWN OF LEXINGTON — BOARD OF PUBLIC WORKS

WATER DIVISION

Sketch of Service Here

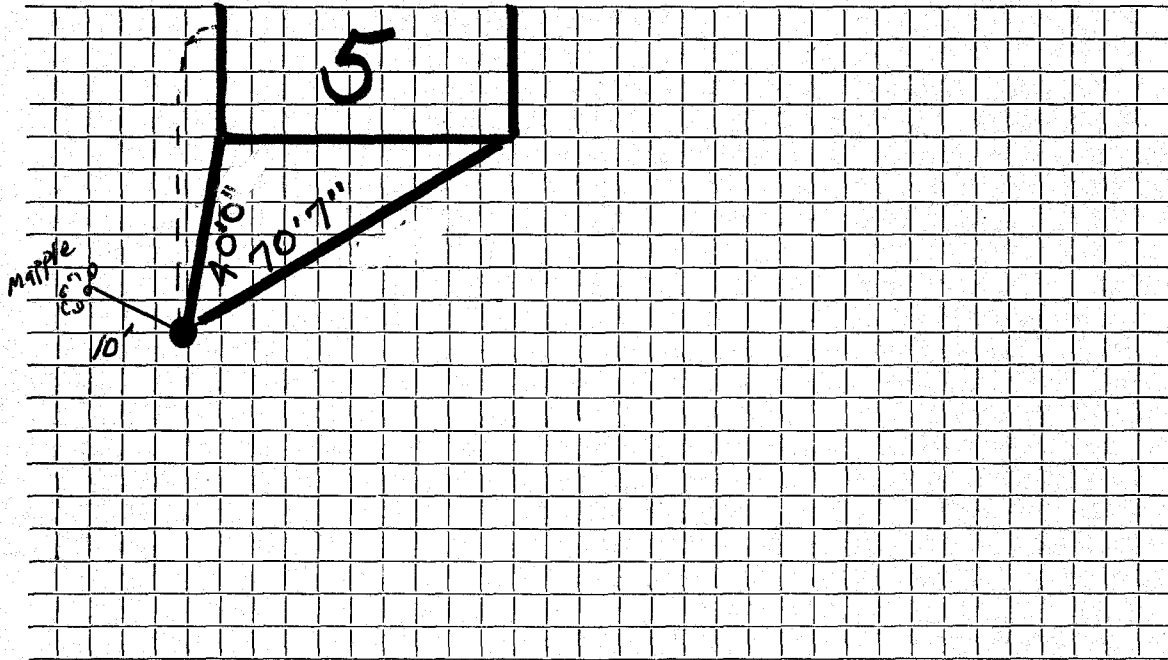

Connection made in ..... Street. Work completed .....

Remarks: .....

.....

.....