

## WATER SERVICE RECORD

# 6526

Name DeVries Construction Company

Service No. 36 N.D.

Address 6 Russell Road

Location

~~Repair or Renewal~~ - New Service

Comm. 4/1/57


Date	Material	Amount	Total	Date	Amount
11/26/56	Labor	1.95		10-21-57 Paid	# 7.86
	10% O.H.	.20	2.15		
	(Owner's Copper)				
	1 3/4" C x 1/2 I.W.H. Stop & Waste		4.96		NON CHARGE
	1 hr. Trucking @.75		.75		Labor
			7.86		1.95
				24' 3/4" Copper tubing @.4396	10.55
				1 3/4" C Corp Cock	4.64
				1 3/4" C Curb Cock	5.94
				1 Box & Rod	4.62
				1 1/2 Straight tail piece	.50
				1 1/2 Offset tail piece	.50
					28.70

DATE \_\_\_\_\_

TOWN OF LEXINGTON — BOARD OF PUBLIC WORKS

**WATER DIVISION**

Sketch of Service Here

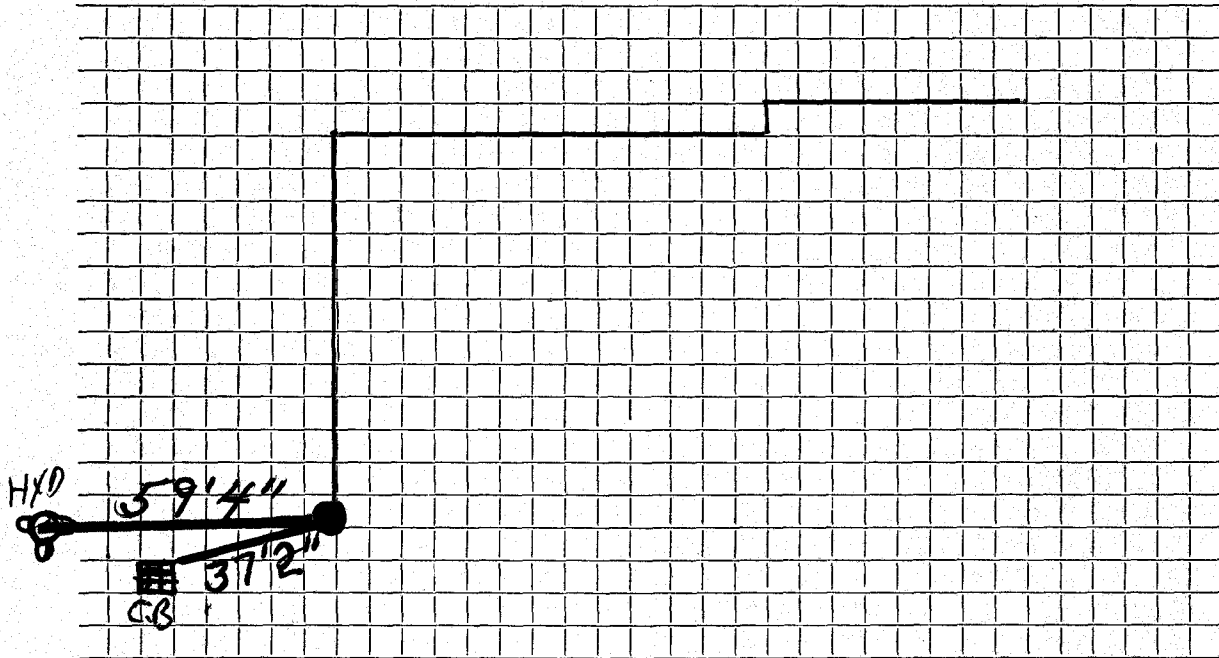

Connection made in ..... Street. Work completed .....

Remarks: .....

.....

.....