

## WATER SERVICE RECORD

Name DeVries Construction Company

Service No. 38 N.D.

Address 9 Russell Road

Location

~~REPAIR - RENEWAL~~ New Service

Comm. 4/1/57

Date	Material	Amount	Total	Date	Amount
11-26-56	Labor	1.95		10-21-57 Paid	\$ 7.86
	10% O.H.	.20	2.15		
	(Owner's Copper)				
1	3/4" C x 1/2 I.W.H. Stop & Waste		4.96		NON CHARGE
1	hr. Trucking @.75		.75		Labor
			7.86		24' 3/4" Copper tubing @.4396
					10.55
					1 3/4" C Corp Cock
					4.61
					1 3/4" C Curb Cock
					5.91
					1 Box & Rod
					4.62
					1 1/2 Straight Tail Piece
					.50
					1 1/2 Offset Tail Piece
					.50
					28.70


Bill sent 4/3/57

DATE \_\_\_\_\_

TOWN OF LEXINGTON — BOARD OF PUBLIC WORKS

WATER DIVISION

Sketch of Service Here

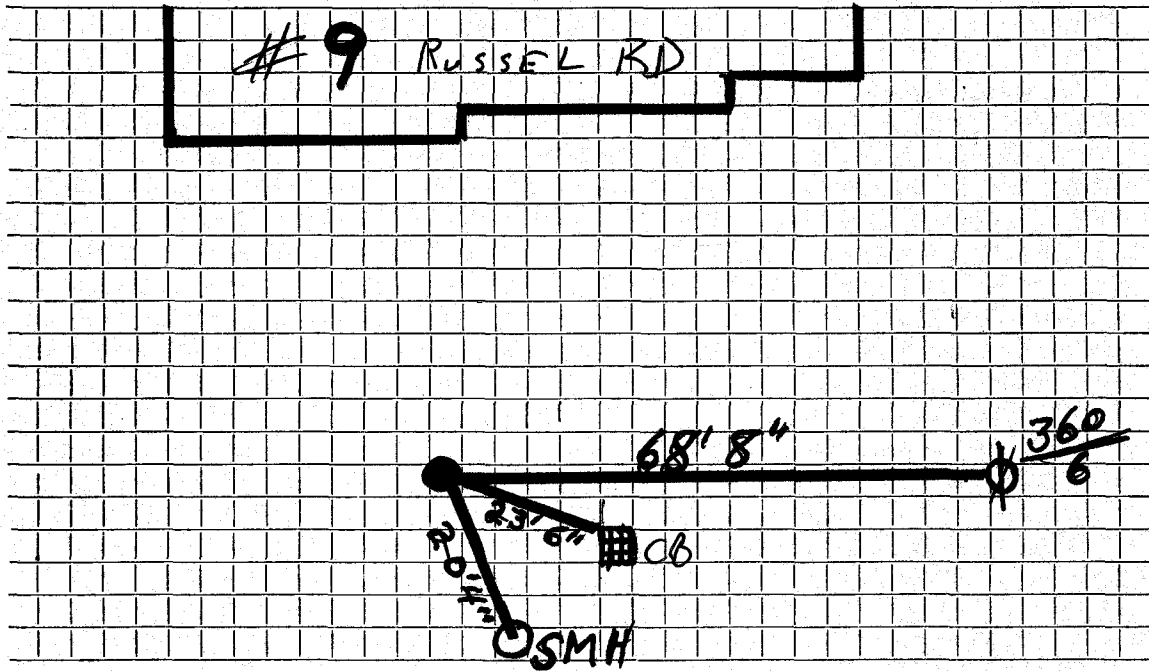

Connection made in ..... Street. Work completed .....

Remarks: .....

.....

.....