




DATE \_\_\_\_\_

TOWN OF LEXINGTON — BOARD OF PUBLIC WORKS

WATER DIVISION

#16  
#13

Sketch of Service Here

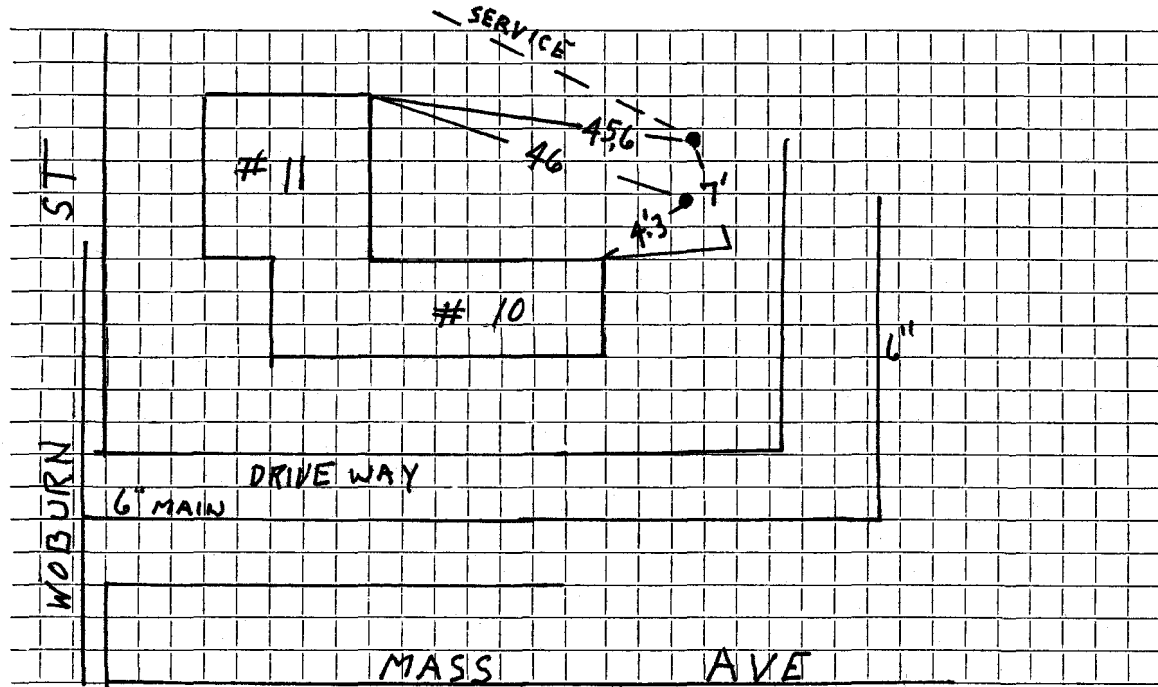

Connection made in ..... Street. Work completed .....

Remarks: .....

.....

.....