

Name *Russo*

Address *Russell Street*

Service No. *777*

*END OF EAST ST.*

Location *Russell St. (House 17 Woburn)*

Kind of Pipe

Size

Size of Main

Repair—Renewal—New Service

Location

Date	Material	Amount	Total	Date	Amount
	Labor				

DATE

# TOWN OF LEXINGTON—BOARD OF PUBLIC WORKS WATER DIVISION

The undersigned applies for a supply of water at No. Russell Street St. and hereby agrees to comply with the rules and regulations as now, or at any future time, established by the Board of Selectmen.

Am't. of Estimate \$ \_\_\_\_\_

Owner Fusso


Am't. Paid \$ \_\_\_\_\_

Address Russell Street

Builder \_\_\_\_\_

House 10 Hobarr

Sketch of Service Here

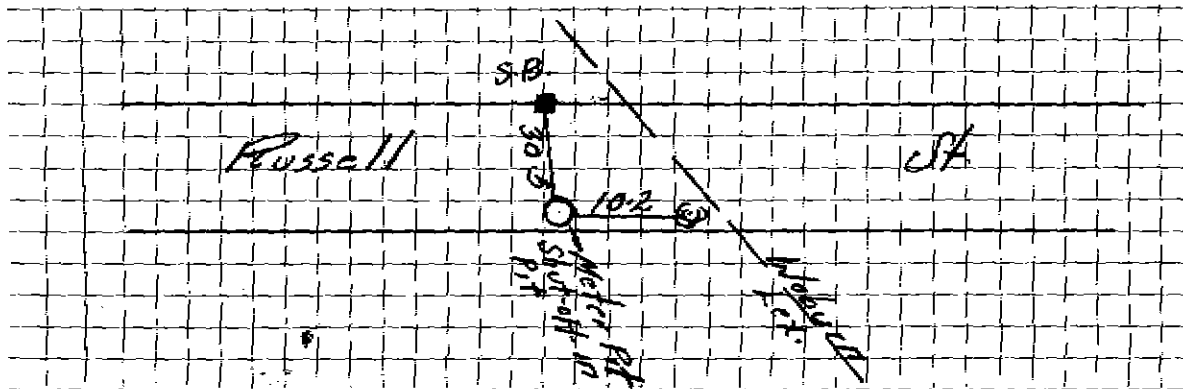

Connection made in \_\_\_\_\_ Street.

Work completed \_\_\_\_\_ 19

Remarks: