

WATER SERVICE RECORD

958

Name Mark Moore Jr.

Service No. #50

Address 11 Saddle Club Road

Location Lot #17 Sta. 8+78

~~Repair~~ ~~Renewal~~ New Service

WO # 7232


Comm 12-1-62

Date	Material	Amount	Total	Date		Amount
5-15-62	Labor	13.34		5-14-62	Deposit	25.00
	10% O.H.	1.33	14.67	5-14-62	Resund	1.14
1	3/4" X 1/2" I.W.H. Stop & Waste		6.17			23.87
1	Hr. Trucking : 3.00@		3.00			
			23.84		NON CHARGE	
				5-15-62	Labor	4.26
				15'	3/4" Copper tubing @42	6.30
				1	3/4" C Corp Cock	4.91
				1	3/4" C Curb Cock	6.28
				1	Box & Rod	4.90
				1	1/2" Straight tailpiece	.50
				1	1/2" Offset Tailpiece	.50
						27.65

TOWN OF LEXINGTON — BOARD OF PUBLIC WORKS

WATER DIVISION

Sketch of Service Here

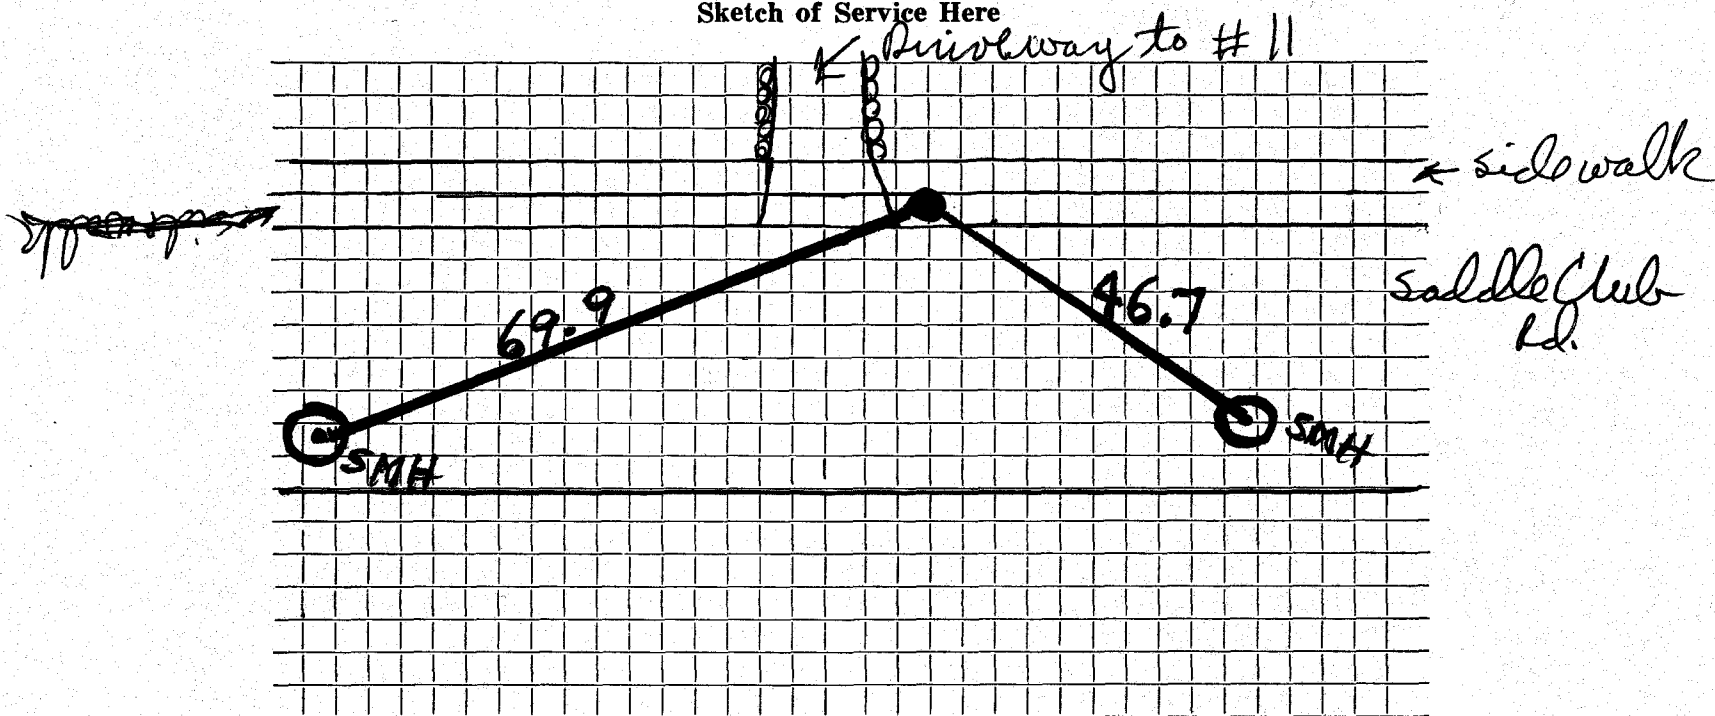

Connection made in Street. Work completed

Remarks:

.....

.....