

WATER SERVICE RECORD

Name Foley Const. Co.

Service No. 237

Address 12 Saddle Club Road

7520

Location Lot #16 Sta. 8+45

~~Repair Service~~ - New Service DeFlice Bros. Permit #A115


JUL 25 1966

Date	Material	Amount	Total	Date	Amount
6-19-62	Labor	1.70		11-19-65	38.60
	10% O.H.	.17	1.87		
	4' 3/4" Copper tubing @.42		1.68		
	1 hr. Trucking @3.00		3.00		
	BILL WHEN CONNECTED		6.55		
					NON CHARGE
				6-19-62	Labor 7.14
					21' 3/4" Copper tubing @.42 8.82
					1 3/4" C Corp Cock 4.91
					1 3/4" C Curb Cock 6.28
					1 Box & Rod 4.90
					32.05
					6.55
					<u>38.60</u>

TOWN OF LEXINGTON — BOARD OF PUBLIC WORKS

WATER DIVISION

Sketch of Service Here

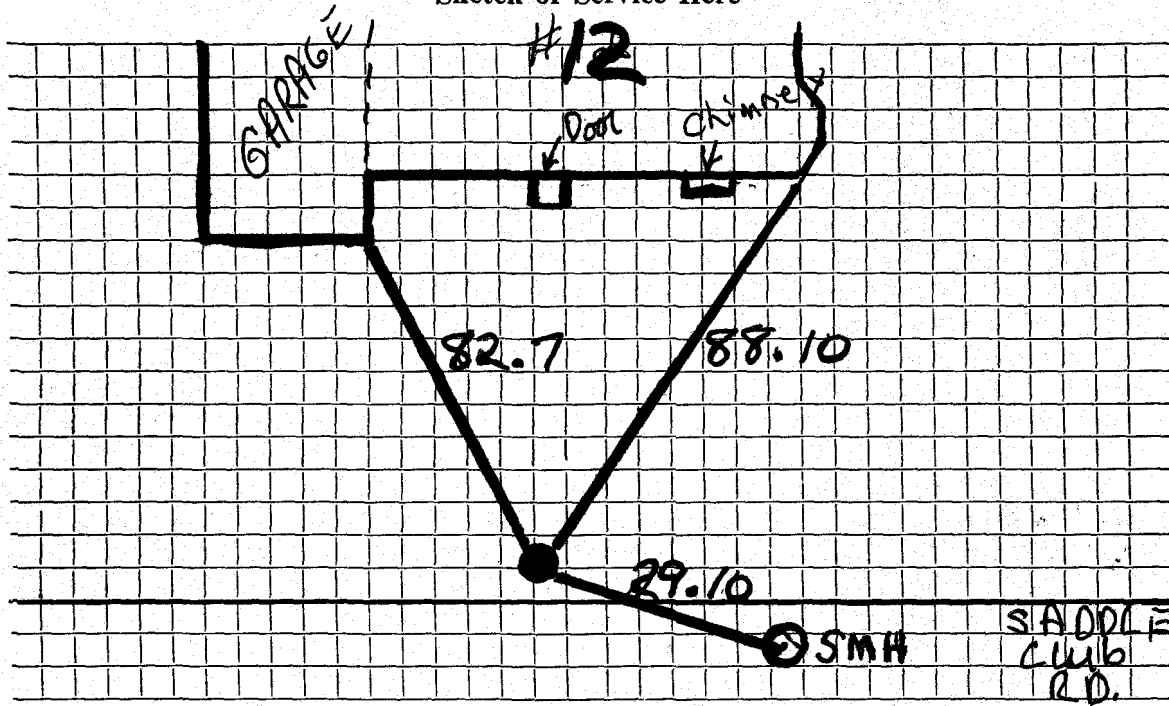

Connection made in Street. Work completed

Remarks:

.....
.....