


DATE July 8/2004

TOWN OF LEXINGTON — BOARD OF PUBLIC WORKS

WATER DIVISION

15 Saddle Club Rd.

Sketch of Service Here

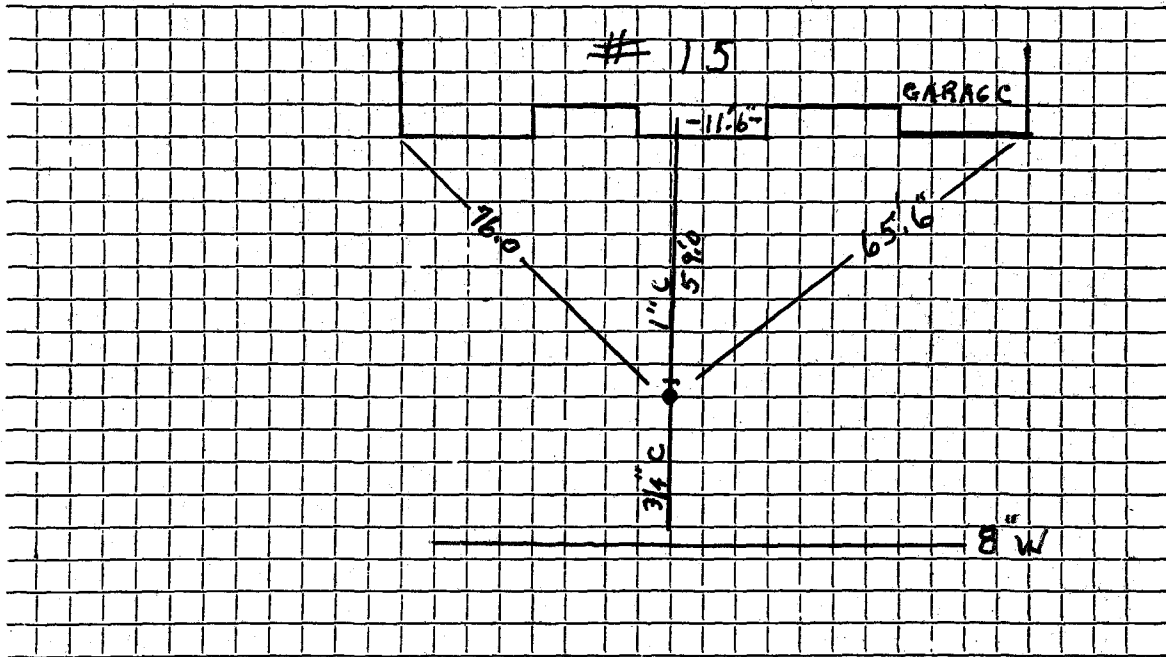

Connection made in Street.

Work completed 7/8/04 J. McLaughlin

Remarks:
.....
.....