

WATER SERVICE RECORD

Name JD Alward Corp

Service No.

Address 17 Saddle Club Rd

Location

Repair ~~Renewal~~ New Service


Date	Material	Amount	Total	Date		Amount
8/26/2020	1" type K copper pipe					
	1" curb stop comb. brass open right					
	1" to 3/4" union					

DATE 8/26/2020

TOWN OF LEXINGTON — BOARD OF PUBLIC WORKS

WATER DIVISION

Sketch of Service Here

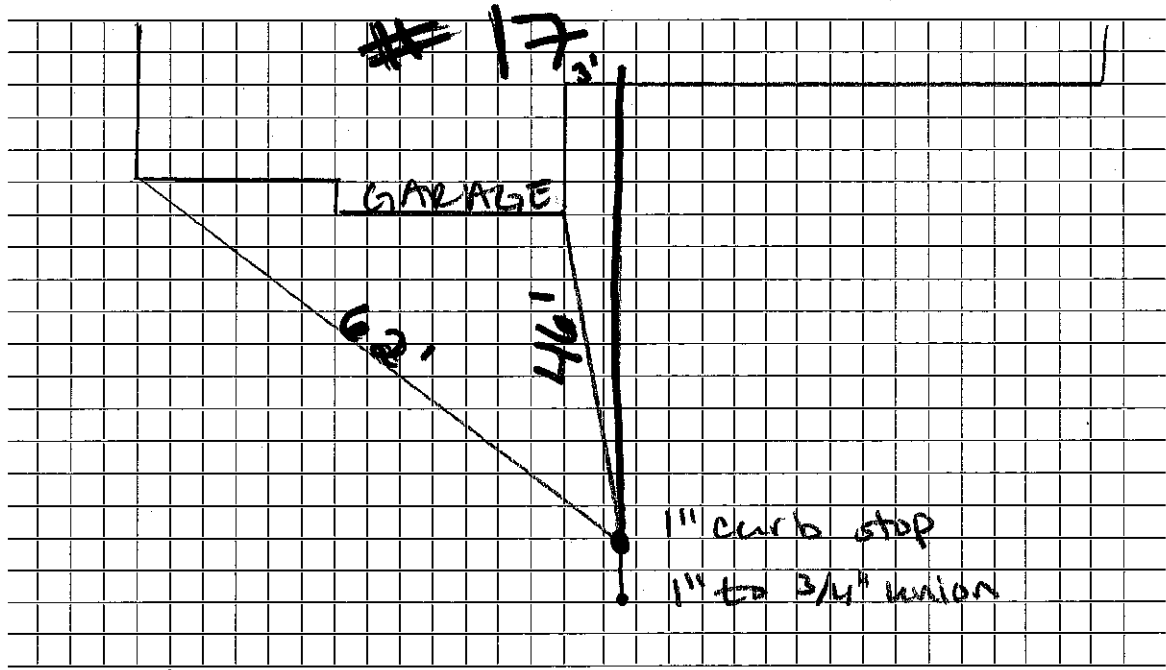

Connection made in Saddle Club Rd Street.

Work completed

Remarks:.....
.....
.....