

WATER SERVICE RECORD

Name MOORE REALTY TRUST

Service No. 42

Address 25 SADDLE CLUB Rd.

Location LOT 49

~~Repair~~ ~~Renewal~~ New Service

Defelice #3202 KLO.# 91
Defelice Bros. Permit #17

DEC. 26 1978


Date	Material	Amount	Total	Date	Amount
7-14-64	38' of 6" copper		300.00	11-9-78	DEPOSIT
					550.00
11-29-78	Labor	76.92			108.87
	10% O.H.	7.69	84.61		441.16
	2 hrs Trucking		6.00		
	1/2 hr. Beckhoe		9.75		
	1/2 Ton cold patch		7.50		
	HOT TOP 5'x4'		13.32		
	HOT TOP 6'x5'		19.98		
			<u>441.16</u>		
Provided by owner	16' 1/2" copper				
	1/2" x 8" Service Saddle				
	1/2" curb cock				
	1/2" corp.				
	1 Gate box				
12/5/78	79' 1/2" copper				

DATE _____

TOWN OF LEXINGTON — BOARD OF PUBLIC WORKS

WATER DIVISION

Sketch of Service Here

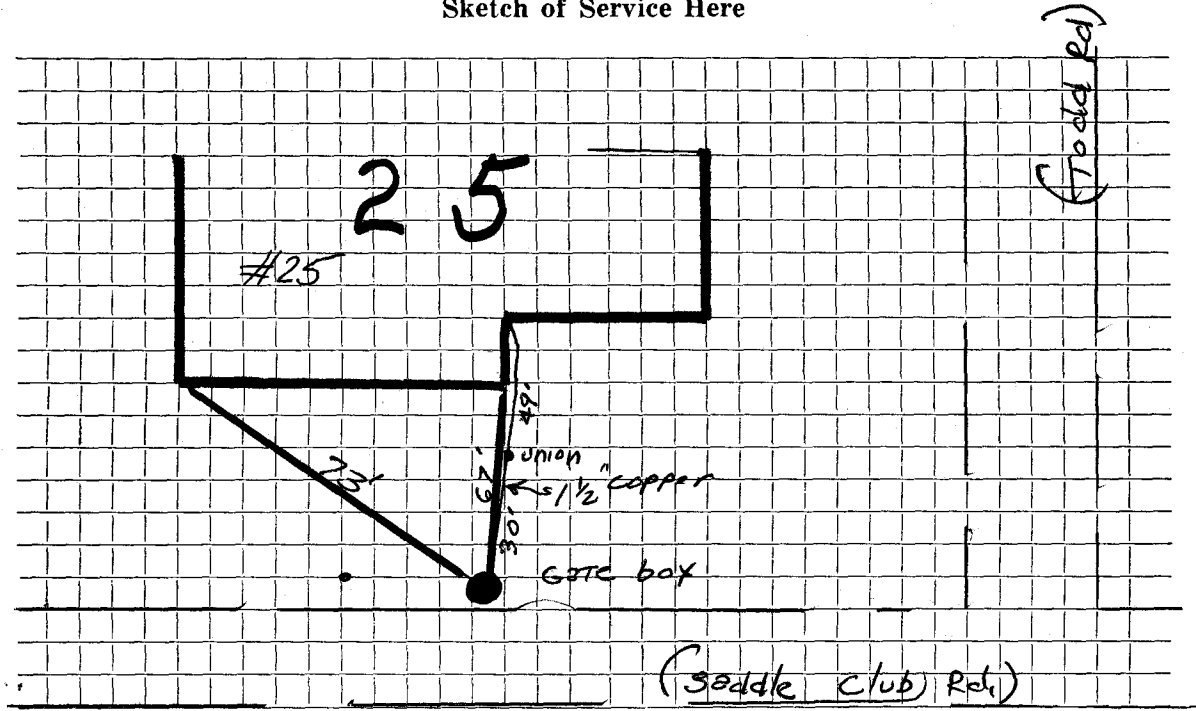

Connection made in Street. Work completed

Remarks:
.....
.....