




DATE 7.97

TOWN OF LEXINGTON — BOARD OF PUBLIC WORKS

WATER DIVISION

Sketch of Service Here

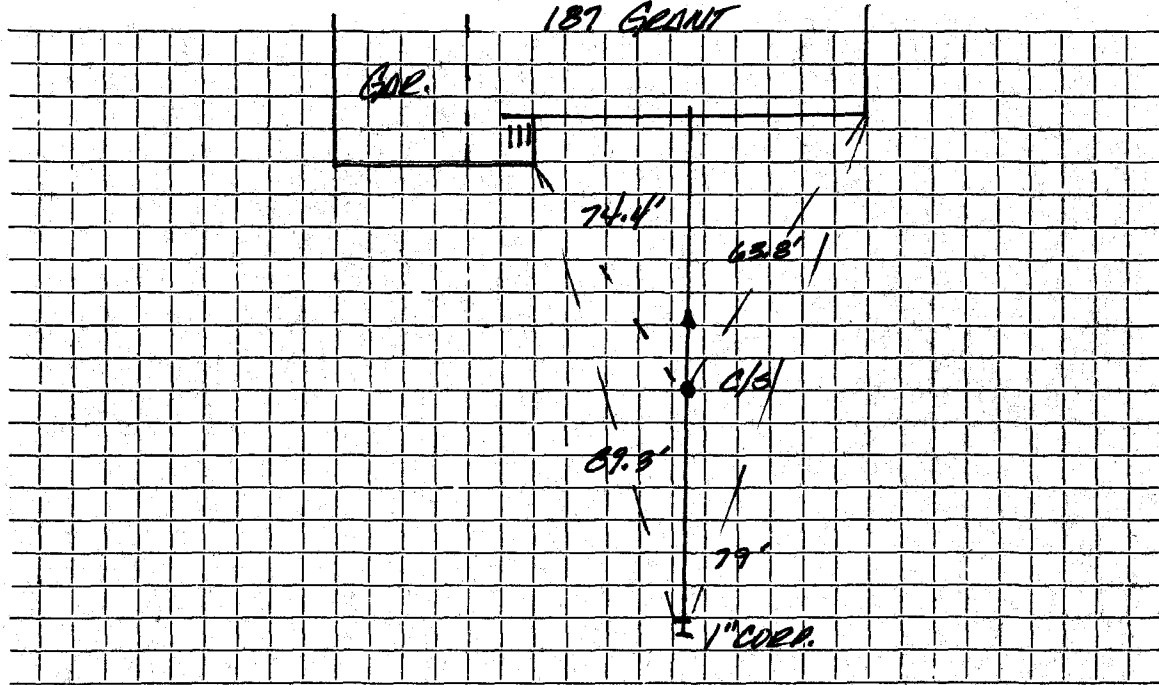

Connection made in ..... GRANT Street. Work completed ..... CONTRACT 96-2

Remarks: .....  
.....  
.....