




TOWN OF LEXINGTON — BOARD OF PUBLIC WORKS

WATER DIVISION

Sketch of Service Here

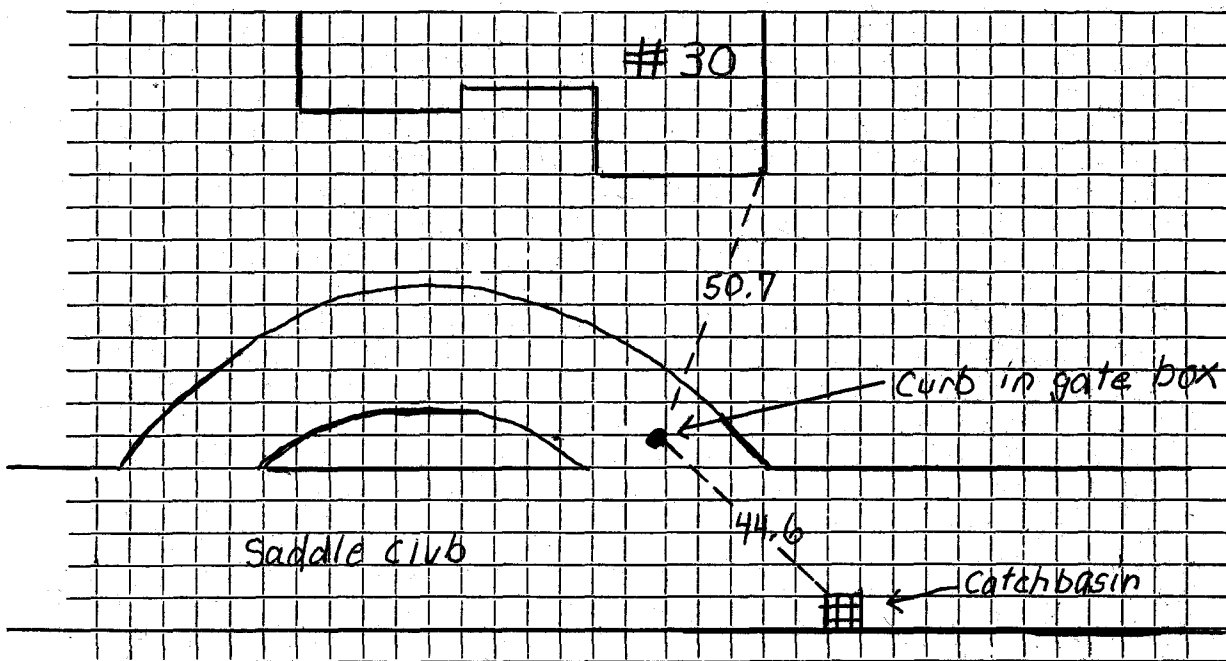

Connection made in ..... Street. Work completed .....

Remarks: ..CAT.V.- Street Side of Box.....  
.....Edison line over service line @ same depths.....  
.....Curb in gate box.....