

WATER SERVICE RECORD

Name

Service No.

Address 39 SADDLE CLUB ROAD

Location


Repair ~~Renewal~~ New Service

Date	Material	Amount	Total	Date	Material	Amount
9-20-72	23 LF 3/4" COPPER			9-27	26 LF 1" COPPER	
	1 3/4" C/S				1 C/S W/B BOX	
	1 3/4" CORR.				1 1" CORR.	
	1				1 1" X 3/4" UNION	

DATE 10.18.96

TOWN OF LEXINGTON — BOARD OF PUBLIC WORKS

WATER DIVISION

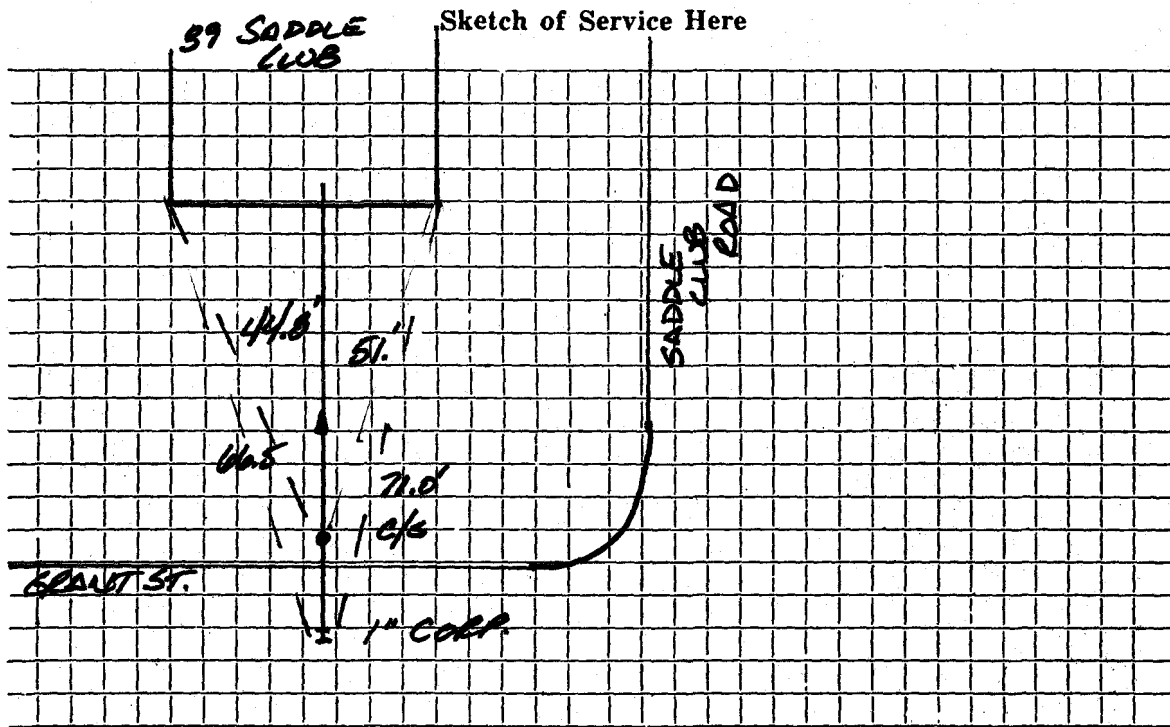

Connection made in GRANT Street. Work completed CONTRACT 96-2

Remarks:
.....
.....