
Date: 4/16/교식

TOWN OF LEXINGTON - BOARD OF PUBLIC WORKS WATER DIVISON

SKETCH OF SERVICE HERE

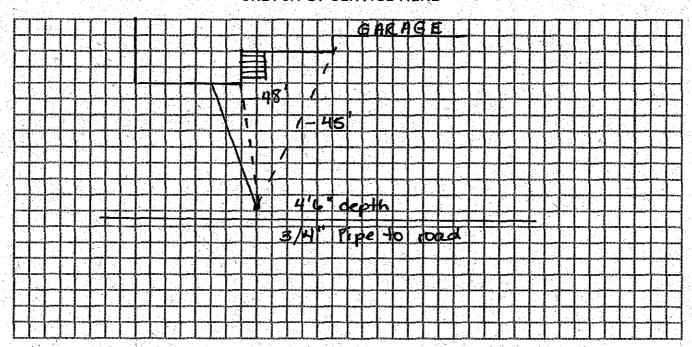

Connection made in:

Street.

Work completed:

Remarks: Installed by Speedwagon

Water Service Record

Name 4 Saddle Club Rd	Service No.		
Address			
Location			

Repair - Renewal - New Service

Date	Material	Amount	Total	Date		Amount
4/14/24	I" K copper					
	1" curb stop		· .			
	1" curb stop open-right					
						·
	Buffalo Box					
				<u> </u>		
<u></u>	·					
	·	<u></u>				<u>.</u>
				<u> </u>	<u></u>	
				<u> </u>		
		-				