

## WATER SERVICE RECORD

# 537

Service No. 127

Name R.J.Foley Realty Trust

Address 6 Saddle Club Road

Location Lot #13 Sta. 3+45

~~Repair~~ New Service DeFlice Bros - Permit #147


DEC 28 1964

| Date    |     | Material           | Amount | Total | Date     | Amount                            |
|---------|-----|--------------------|--------|-------|----------|-----------------------------------|
| 12-1-64 | 57' | 3/4" Copper tubing |        |       | 10-29-64 | <i>Repair P</i> 36.61             |
|         |     |                    |        |       |          | NON CHARGE                        |
|         |     |                    |        |       | 6-19-62  | Labor 9.18                        |
|         |     |                    |        |       |          | 27' 3/4" Copper tubing @.42 11.34 |
|         |     |                    |        |       |          | 1 3/4" G Corp Cock 4.91           |
|         |     |                    |        |       |          | 1 3/4" C Curb Cock 6.28           |
|         |     |                    |        |       |          | 1 Box & Rod 4.90                  |
|         |     |                    |        |       |          | 36.61                             |

DATE \_\_\_\_\_

TOWN OF LEXINGTON — BOARD OF PUBLIC WORKS  
**WATER DIVISION**

Sketch of Service Here

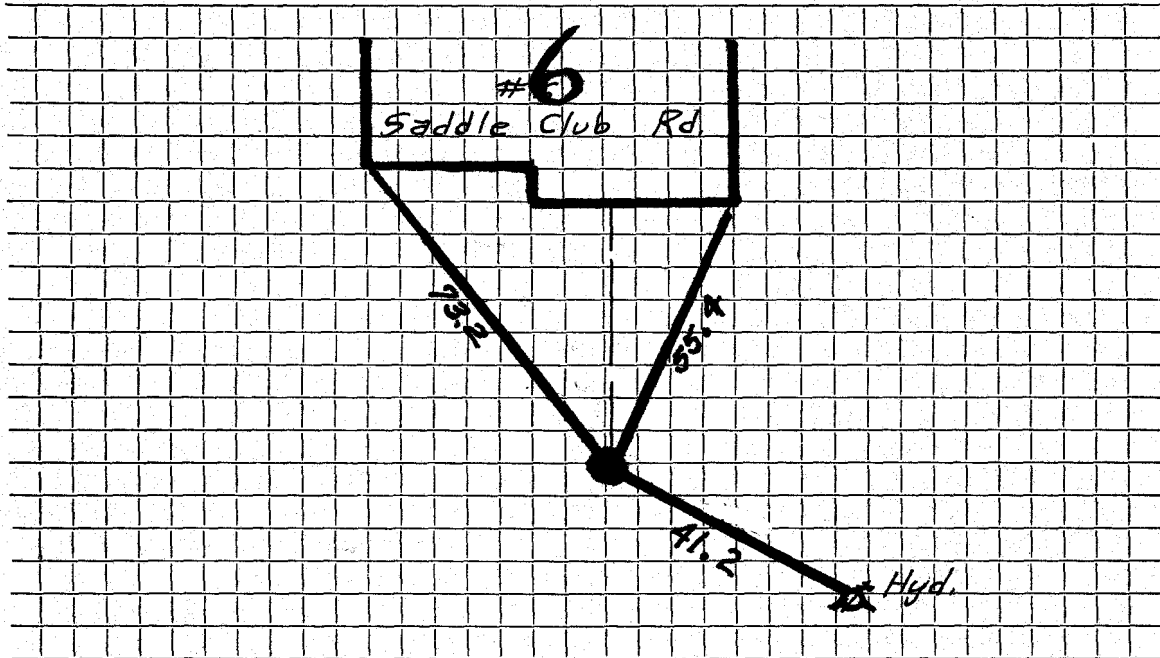

Connection made in ..... Street. Work completed .....

Remarks: .....

.....

.....