

## WATER SERVICE RECORD

Name Moore Realty Trust

Service No. 118

Address 7 Saddle Club Road

Location Lot #29 Sta. 5+24

~~REPAIR WORK~~ New Service

WO# 8256

Comm 2-10-64


Date	Material	Amount	Total	Date	Amount	
6-19-62	Labor	3.74		10-21-63	Deposit	75.00
	10% O.H.	.37	4.11	2-10-64	Returned	16.38
	11' 3/4" Copper tubing @.42		4.62			58.62
	1 hr. Trucking @3.00		3.00			
	BILL WHEN CONNECTED		11.73		NON CHARGE	
10/29/63	Labor	2.42		6-19-62	Labor	4.08
	10% O.H.	2.4	2.66		12' 3/4" Copper tubing @.42	5.04
	72' 3/4" Copper Tubing @ .42		30.24		1 3/4" C Corp Cock	4.91
	1 3/4" Cx 1/2 I.W.H. Stop & Waste		6.17		1 3/4" C Curb Cock	6.28
	2 3/4" C3 Part Unions @ 2.41		4.82		1 Box & Rod	4.90
	1 Hr. Trucking @ 3.00		3.00			25.21
			58.62		1 1/2 Straight Tailpiece	50
					1 1/2 Offset Tailpiece	50
						26.21

DATE \_\_\_\_\_

TOWN OF LEXINGTON — BOARD OF PUBLIC WORKS

**WATER DIVISION**

Sketch of Service Here

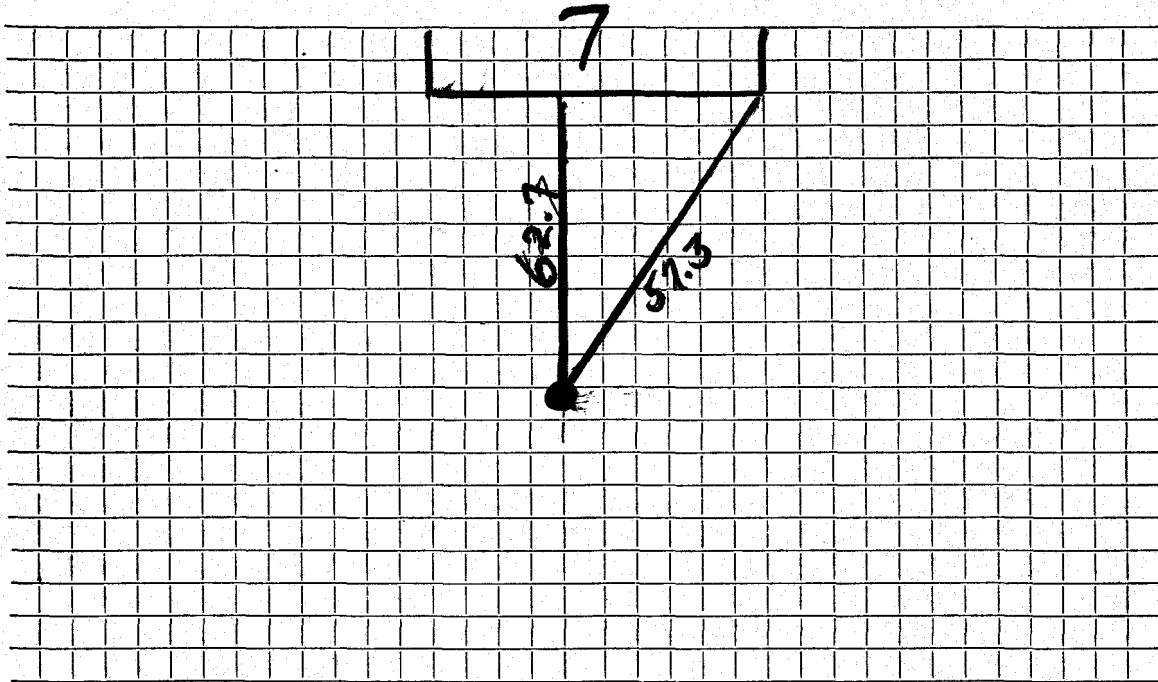

Connection made in ..... Street. Work completed .....

Remarks: .....

.....

.....