




DATE \_\_\_\_\_

# TOWN OF LEXINGTON — BOARD OF PUBLIC WORKS

## WATER DIVISION

Sketch of Service Here

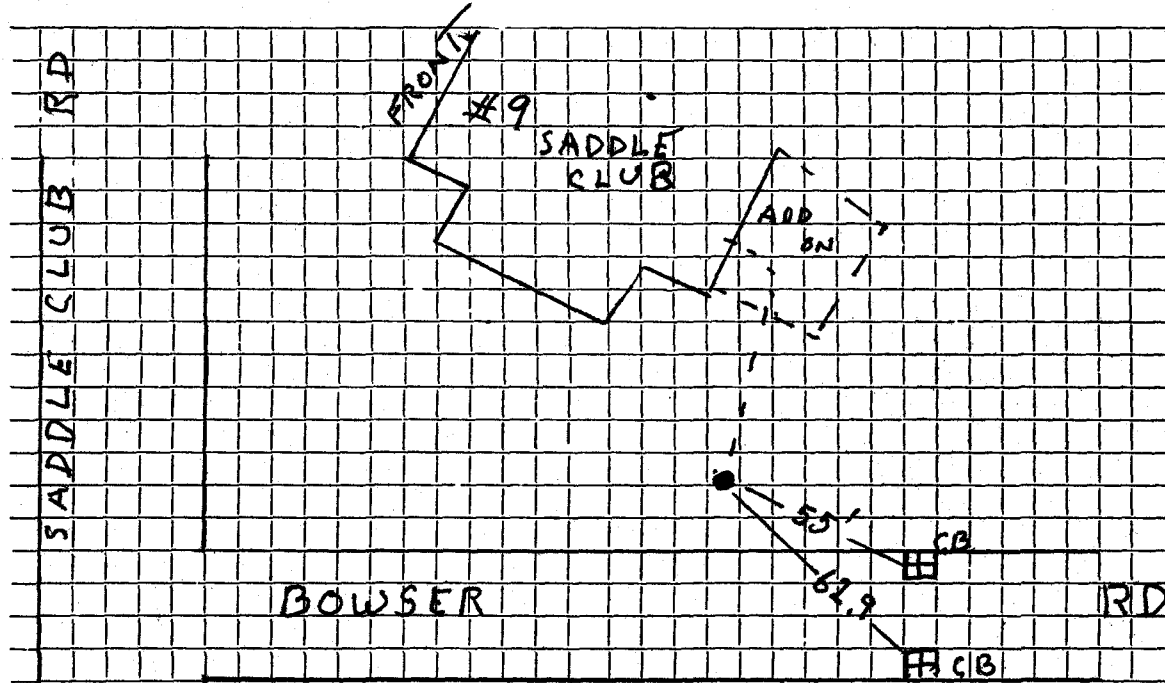

Connection made in BOWSER ..... Street. Work completed .....

Remarks: .....  
.....  
.....