


DATE _____

TOWN OF LEXINGTON — BOARD OF PUBLIC WORKS

WATER DIVISION

LOT 7

Sketch of Service Here

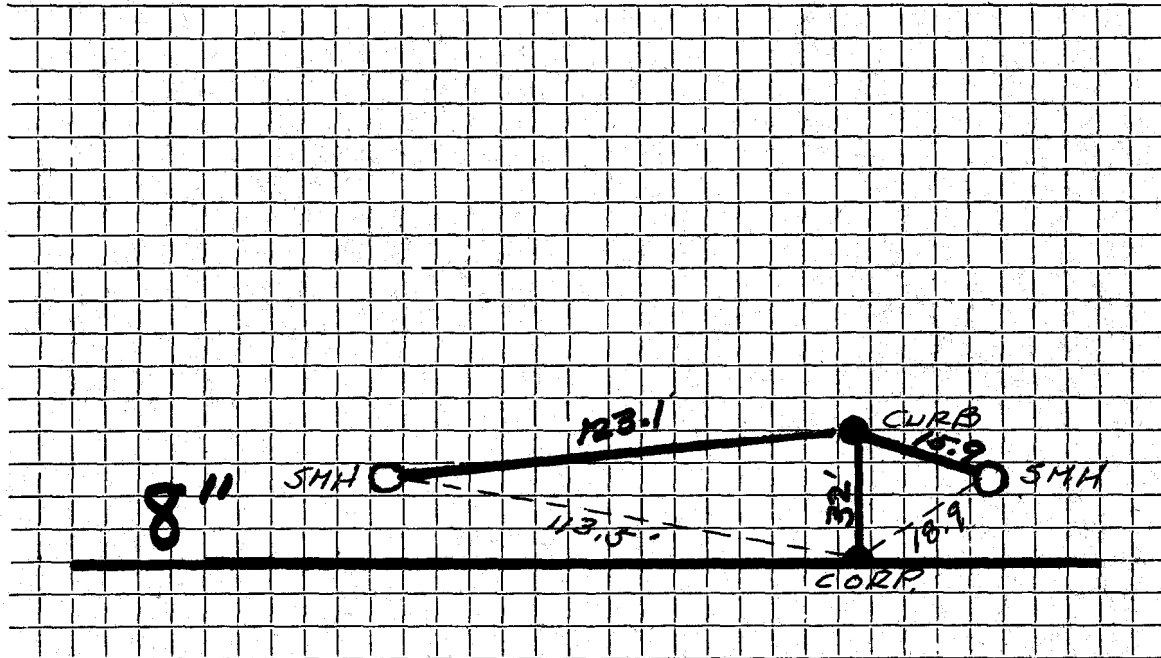

Connection made in SANDERSON RD. Street. Work completed

Remarks:
.....
.....