


DATE 12/2/02

TOWN OF LEXINGTON — BOARD OF PUBLIC WORKS

WATER DIVISION

Sketch of Service Here

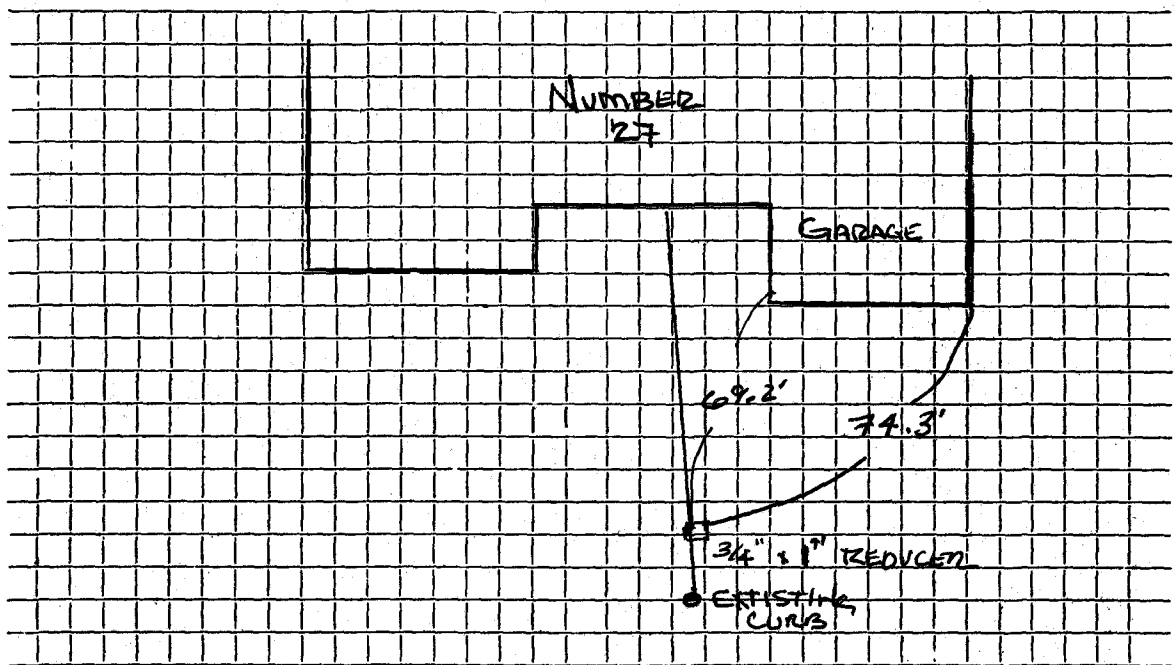

Connection made in Street. Work completed

Remarks: NEW 1" LINE WITH 3/4" REDUCER

L = 86' REDUCER TO FOUNDATION

DEPTH @ UNION = 7.5'