




DATE 7/2018

TOWN OF LEXINGTON — BOARD OF PUBLIC WORKS  
WATER DIVISION

Sketch of Service Here

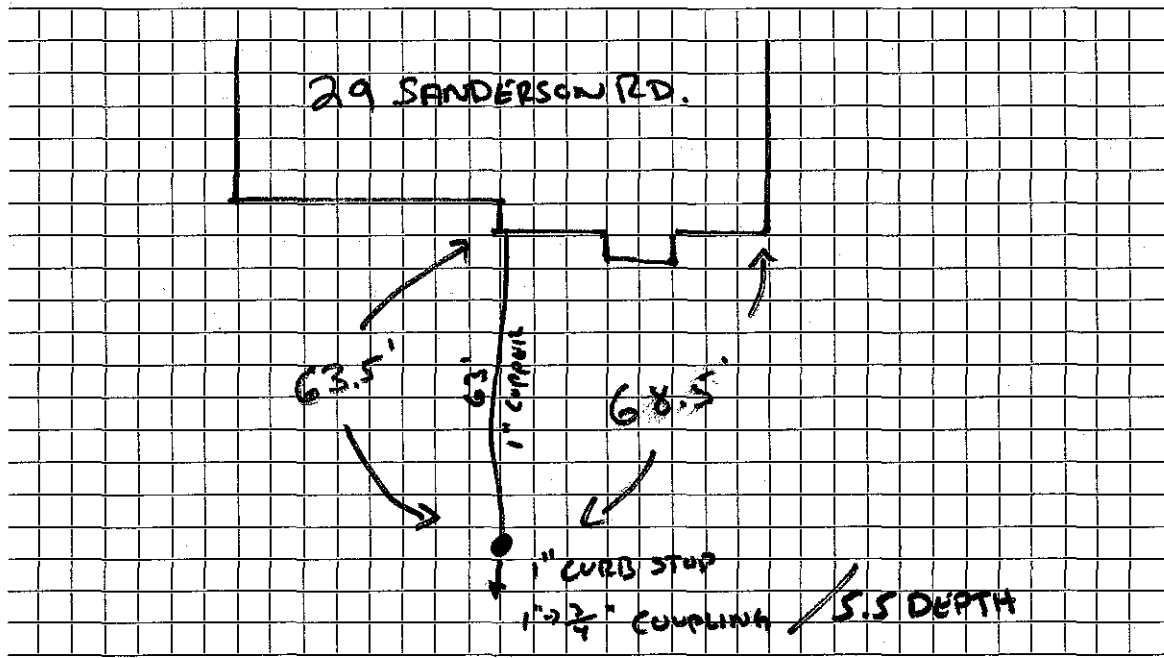

Connection made in... SANDERSON Street. Work completed ..... JOE HANKINS

Remarks:.....  
.....  
.....