




DATE \_\_\_\_\_

TOWN OF LEXINGTON -- BOARD OF PUBLIC WORKS

**WATER DIVISION**

Sketch of Service Here  
#33 Sanderson Road  
Lot #17

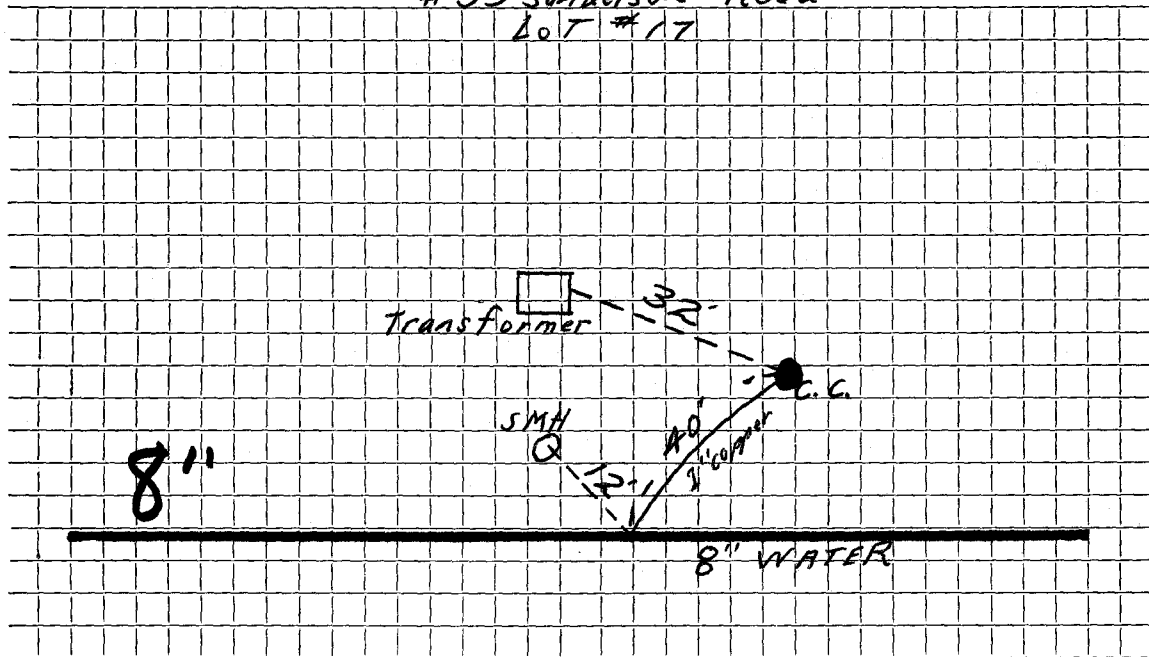

Connection made in Sanderson Road ~~Street~~ Work completed .....

Remarks: .....

.....

.....