


DATE _____

TOWN OF LEXINGTON -- BOARD OF PUBLIC WORKS

WATER DIVISION

Sketch of Service Here

40 Sanderson Road
Lot # 4

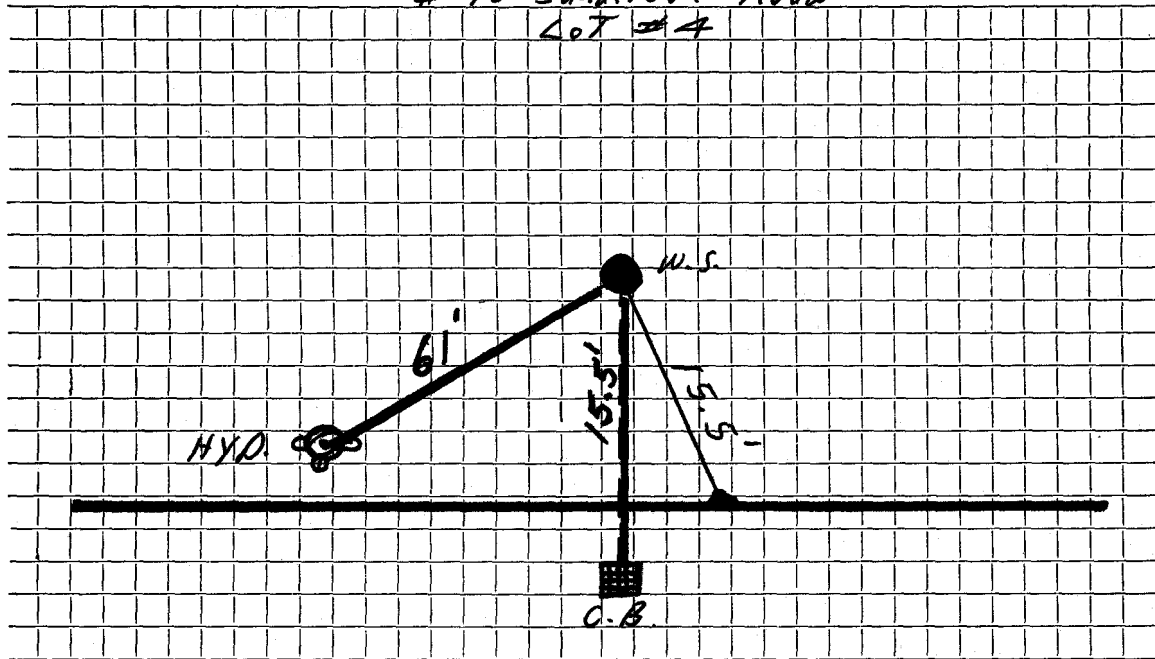

Connection made in Street. Work completed

Remarks:

.....

.....