

WATER SERVICE RECORD

Name

Paul Schimmel

Service No.

Address

44 Sanderson Road

Location

Repair—Renewal—New Service


Date	Material	Amount	Total	Date	Amount
6/8	76 11' = 1" copper				
6/18	76 54' = 1" copper				
10-26-82	TWO-3PART UNIONS & 18"x1" COPPER TUBE				
				Repair made	
				2-6-92	
				2'-1" COPPER	
				1- Comp Corp.	
				1- Comp 3 part union	

DATE _____

TOWN OF LEXINGTON — BOARD OF PUBLIC WORKS

WATER DIVISION

Sketch of Service Here

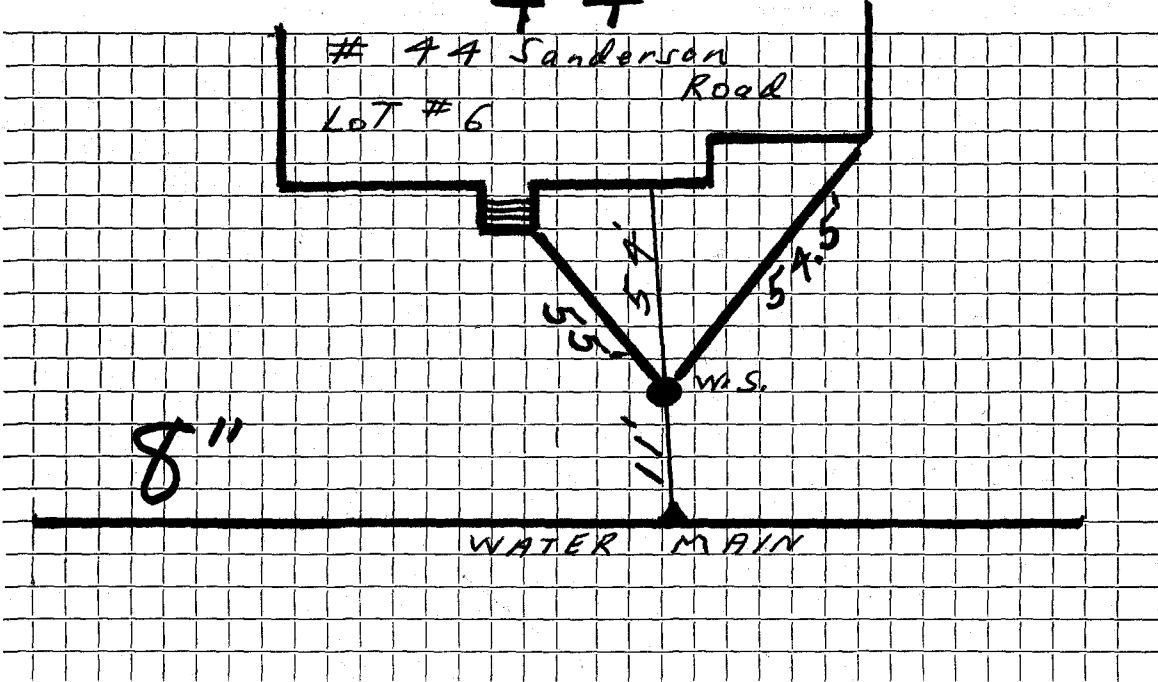

Connection made in Street. Work completed

Remarks: 18" PEICE OF 1" COPPER TUBE WITH TWO "3" PART UNIONS INSTALLED 10-26-82 - 4'6" DEEP & 4'6" OUT FROM HOUSE